

HAR. M683 1168B15409
5-15-63

WATER WELL DRILLERS LOG CODED

Date: 5-15, 1963, Driller: C. T. SWITZER WELL CO. County: Harrison

Drilled deeper (Name)

(1) Owner of Land: Dr. R. A. Patten
(Name)
939 - 1st St. Mulport
(Address)
(2) Location: 33 7/10 1/4, 7 10 1/4, Sec. 7 10
_____ miles _____ of _____
(distance) (direction) (Nearest Town)
(3) Topography: _____
(Hilly) (Flat) (Level)
(4) Purpose of Well: Domestic
(Domestic Irrigation
Municipal, Industrial, Other)


Description & Color of Materials Sand, Clay, Red Clay, Shell, etc.	Thick- ness Feet	Depth Feet
Sand	60	45
Clay	45	84
Sand	84	110
Clay	110	148
Sand	148	180
Sand, fine	180	190
Clay	190	225
Sand	225	233
Clay	233	240
Sand, pool	240	245

Information upon completion of well:

(1) Diameter 2 inches.
(2) Total Depth 245 feet.
(3) Water Level 4-1 feet below top of ground.
(4) Cased to 245', Size 2 1/2"
(5) Screen: Size 2", Length 10'
(6) Were any formations sealed against pollution?
 yes, _____ no.

If YES depth of formation _____
Why North Dept. requirements
Drillers Remarks: _____

CODED

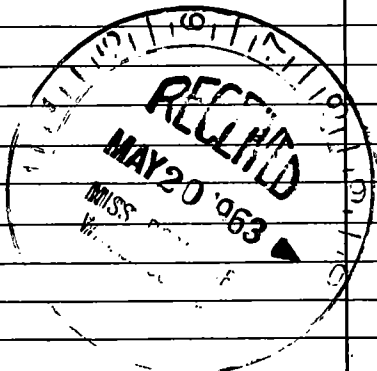

(Use Back Side)

Well No.

