

TRISON

M685

4-80

MISSISSIPPI
 BOARD OF WATER COMMISSIONERS
 416 North State Street
 Jackson, Mississippi 39201

CODED

WATER WELL DRILLERS LOG

10-4-19 date well completed. 80 McNeil Well Drilling firm name Harrison county well located

LANDOWNER: John C. Price
 701 Shirley Drive
 Get. Ms
 (mailing address)

WELL LOCATION:
 sec. 4 SW 4 SE 4
 4-7-00 Harrison County
 6 miles NE of Get.
 (distance) (direction) (nearest town)

WELL PURPOSE: none
 (home, irrigation, municipal, industrial)

WELL COMPLETION DATA:

- (1) diameter (inches) 2"
- (2) total depth (feet) 340'
- (3) static water level (feet) 20' below top of ground
- (4) casing PVC 330'
 (material) (depth)
 (size) if telescope see back.
- (5) screen 10'
 (length) (depth to top)
 2" (size) (material) 10 steel
- (6) pump 1 14
 (HP) (yield gpm)
 electric (type power)
- (7) electric log no
 (yes or no)
 (organization running log)
- (8) how well bottom plugged sand
 mark

description of formations encountered	from	to
top soil	0	30
white clay	30	60
sand - med	60	90
blue clay	90	130
mud	130	175
slush	175	190
mud - sand	190	230
blue clay	230	260
mud - sand	260	295
blue clay	295	310
fine sand	310	320
source sand	320	340

CODED

DEPT. OF NATURAL RESOURCES
 BUREAU OF LAND & WATER RESOURCES

SEP - 7 1982

RECEIVED


DRILLERS REMARKS:

If well telescopes please sketch and show depths.

WCSMUA

08-9-01

GROUND LEVEL

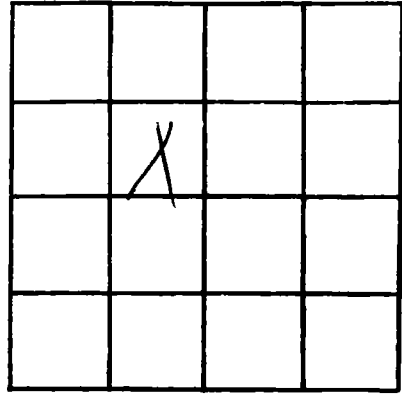

SECTION

4

Please indicate well location X.

ADDITIONAL INFORMATION

If more than one screen, show locations of each on sketch.