

MISSISSIPPI DEPARTMENT OF NATURAL RESOURCES

Bureau of Land and Water Resources

Southport Mall

P.O. Box 10631

Jackson, Mississippi 39209

WATER WELL DRILLERS LOG

COASTAL DRILLING & SERVICE CO.

ROUTE 1 BOX 618

county well located

BILOXI, MISS. 39532

HARRISON  
M 45686  
48183

date well completed 4/18/83

LANDOWNER

description of formations encountered

from to

401. Culbuck St

Top Soil

1 3

Biloxi MS 39532

Super Sand

3 35

(mailing address)

allite sand

35 90

WELL LOCATION:

sec. 27 T. 7 N. R. 9 E. W. 1  
Nashville Richard Co.

Self Blue Clay

90 210

(distance) (direction) (nearest town)

Super Sand

210 240

WELL PURPOSE: Industrial

Self Blue Clay

240 310

WELL COMPLETION DATA:

hard blue clay

310 510

(1) diameter (inches) 8 1/2"

fine wet sand

510 530

(2) total depth (feet) 628'

hard blue clay

530 580

(3) static water level (feet) 22' below top of ground

fine wet sand

580 595

(4) casing Steel 598' (material) (depth)

good water sand

595 628'

8 1/2" (also) if telescope see back.

(5) screen 30' 598' (length) (depth to top)

6" (size) All S.S. (material)

(6) pump 30HP 265 (HP) (yield gpm)

Elec (type power)

(7) electric log Yes (yes or no)

(organization running log)

(8) how well bottom plugged

DRILLERS REMARKS

CODED

CODED

DEPT. OF NATURAL RESOURCES  
BUREAU OF LAND & WATER RESOURCES


MAR 29 1984

RECEIVED

If well telescopes please sketch and show depths.

GROUND LEVEL  


Handwritten notes in a vertical column, possibly describing well depths or observations. Some legible words include "2 1/2", "2 1/4", "2 1/8", "2 3/8", "2 1/2", "2 1/4", "2 1/8", "2 3/8", "2 1/2", "2 1/4", "2 1/8", "2 3/8".

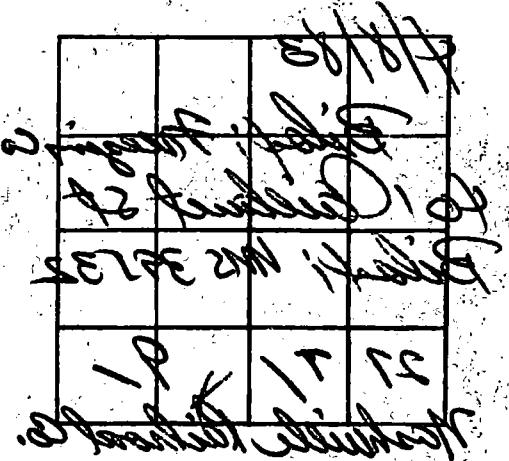

SECTION \_\_\_\_\_  
 Please indicate well location X.

ADDITIONAL INFORMATION

2 1/2" 50'
2 1/4" 30'
2 1/8" 22' 1/2"
2 3/8" 30 1/2"

30' 6" 55' 30" -

6" Johnson Vop  
 back work value

If more than one screen, show locations of each on sketch.

Handwritten signature or notes at the bottom right of the page.