

MISSISSIPPI DEPARTMENT OF NATURAL RESOURCES

Bureau of Land and Water Resources

Southport Mall

P.O. Box 10631

Jackson, Mississippi 39209

WATER WELL DRILLERS LOG  
COASTAL DRILLING & SERVICE CO.

M 687  
Harrison  
4-28-83

CODED

4/28/83 19  
date well completed

ROUTE 1 BOX 618  
firm name

BILOXI, MISS. 39532

Harrison  
county well located

LANDOWNER: Michael Harrison  
P.O. Box 6308  
Biloxi, MS 39532  
(mailing address)

description of formations encountered	from	to
top soil	1	3
Red Clay	3	15
white sand	15	25
Red Sand	25	40
Soft Blue Clay	40	230
Hard Clay Clay	230	305
fine water sand	305	320
Coarse white sand	320	345

WELL LOCATION:  
sec. 5 T. 7 N. R. 9 E  
Shoutabout Bayou River  
(distance) (direction) (nearest town)

WELL PURPOSE: home  
(home, irrigation, municipal, industrial)

- WELL COMPLETION DATA:
- (1) diameter (inches) 2"
  - (2) total depth (feet) 345'
  - (3) static water level (feet) 25' below top of ground.
  - (4) casing PVC, 335' (material), (depth)  
(size) If telescope see back.
  - (5) screen 10', 335' (length), (depth to top)  
2", PVC (size), (material)
  - (6) pump 1/3 (HP), (yield gpm)  
Elc (type power)
  - (7) electric log no (yes or no)  
(organization running log)

(8) how well bottom plugged  
2" lead wire - stable  
DRILLERS REMARKS: 17-13


DEPT. OF NATURAL RESOURCES  
BUREAU OF LAND & WATER RESOURCES

MAR 29 1984

RECEIVED

If well telescopes please sketch and show depths.

GROUND LEVEL

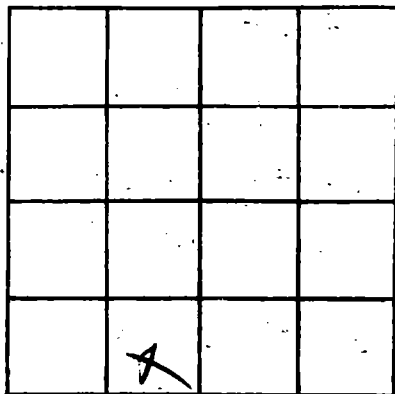

SECTION \_\_\_\_\_

Please indicate well location X.

ADDITIONAL INFORMATION

If more than one screen, show locations of each on sketch.