

MISSISSIPPI DEPARTMENT OF NATURAL RESOURCES

Bureau of Land and Water Resources

Southport Mall

P.O. Box 10631

CODED

Jackson, Mississippi 39209

WATER WELL DRILLERS LOG

COASTAL DRILLING & SERVICE CO.

ROUTE 1 BOX 618

firm name

BILOXI, MISS. 39532

*Hemphill*  
county well located

HARRISON

M 689

8/9/73  
date well completed

LANDOWNER

*Ward Gardner*

description of formations encountered

from

to

*Bill Terry*

*White Sand*

*1 42*

*East Beach Biloxi MS*  
(mailing address)

*5' Yellow Clay*

*42 65*

WELL LOCATION:

sec. *28* T. *7* N. R. *9* E. S. *W*

*Sand*

*65 100*

*East Beach Biloxi*  
(distance) (direction) (nearest town)

*4' Blue Clay*

*100 110*

WELL PURPOSE: *heat pump*  
(home, irrigation, municipal, industrial)

WELL COMPLETION DATA:

- (1) diameter (inches) *4"*
- (2) total depth (feet) *152'*
- (3) static water level (feet) *10* below top of ground.
- (4) casing *10* (material), *152* (depth)

- (5) screen *15'* (length), *137* (depth to top)

- (6) pump *5HP* (HP), *70* (yield gpm)

- (7) electric log *Yes* (yes or no)

(organization running log)

(8) how well bottom plugged  
*2" lead with 1/2" hole*

DRILLERS REMARKS: *12/6*

CODED

DEPT OF NATURAL RESOURCES  
BUREAU OF LAND & WATER RESOURCES

JUL 2 1974


RECEIVED

If well telescopes please sketch and show depths.

GROUND LEVEL

10  
12  
14  
Handwritten notes and sketches in the left column, including a vertical line and various scribbles.

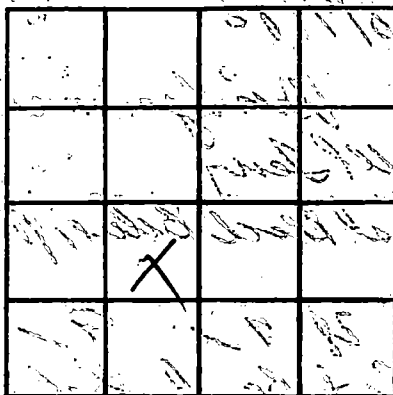

SECTION \_\_\_\_\_

Please indicate well location X.

ADDITIONAL INFORMATION

Multiple horizontal lines for additional information, with some handwritten numbers and scribbles.

If more than one screen, show locations of each on sketch.