

MISSISSIPPI DEPARTMENT OF NATURAL RESOURCES

Bureau of Land and Water Resources

Southport Mall

P.O. Box 10631

Jackson, Mississippi 39209

HARRISON

M 691

CODED

WATER WELL DRILLERS LOG

COASTAL DRILLING & SERVICE CO.

ROUTE 1 BOX 618

BILOXI MISS 39532

Harrison
county well located

8/9/83
date well completed

LANDOWNER

description of formations encountered

from to

Bill Terry
East Beach Biloxi
(mailing address)

White Sand	1	42
Soft Blue Clay	42	65
Grey Sand	65	100
Soft Blue Clay	100	110
Sand + Clay	110	125
fine white sand	125	152

WELL LOCATION:

sec. 28 T. 7 N. R. 9 E. S. 1 W.
East Beach Biloxi
(distance) miles (direction) of (nearest town)

WELL PURPOSE: Heat pump
(home, irrigation, municipal, industrial)

CODED

WELL COMPLETION DATA:

- (1) diameter (inches) 4"
- (2) total depth (feet) 152'
- (3) static water level (feet) 10' below above top of ground.
- (4) casing 4" (material) 137' (depth)
- (5) screen 15' (length) 137' (depth to top)
- 4" (size) PVC (material)
- (6) pump 5HP (HP) 70 (yield gpm)
- 5hp (type power)
- (7) electric log No (yes or no)

(organization running log)

(8) how well bottom plugged
2" fresh water valve
DRILLERS REMARKS: 19-B

DEPT. OF NATURAL RESOURCES
BUREAU OF LAND & WATER RESOURCES


JUL - 2 1984

RECEIVED

if well telescopes please sketch and show depths.

GROUND LEVEL

Handwritten notes and sketches on the left side of the page, including a vertical line and various scribbles.

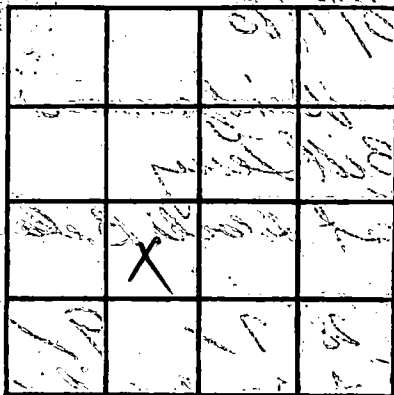

SECTION _____

Please indicate well location X.

ADDITIONAL INFORMATION

Multiple horizontal lines for additional information, with some handwritten notes and numbers.

if more than one screen, show locations of each on sketch.