

MISSISSIPPI DEPARTMENT OF NATURAL RESOURCES

Bureau of Land and Water Resources

Southport Mall

P.O. Box 10631

Jackson, Mississippi 39209

WATER WELL DRILLERS LOG

COASTAL DRILLING & SERVICE CO. *Harrison*

ROUTE # *618*

county well located

HARRISON
M 693

CODED.

1/3/84 19
date well completed

LAND OWNER: *Forest Camp* BILOXI, MISS 39532

description of formations encountered	from	to
<i>top soil</i>	<i>1</i>	<i>3</i>
<i>Red Clay</i>	<i>3</i>	<i>15</i>
<i>Sand (glau)</i>	<i>15</i>	<i>30</i>
<i>Sugar Sand</i>	<i>30</i>	<i>45</i>
<i>Soft Blue Clay</i>	<i>45</i>	<i>210</i>
<i>Hard Blue Clay</i>	<i>210</i>	<i>270</i>
<i>500 water sand</i>	<i>270</i>	<i>310</i>

Inland Blvd T10+67
Biloxi Ms
(mailing address)

WELL LOCATION:

sec *3* T *2* N R *10* E
S W
T 10 + 67 Hwy
(distance) (direction) of (nearest town)

WELL PURPOSE:

(home, irrigation, municipal, industrial)
PO. Private Well

CODED

WELL COMPLETION DATA

- (1) diameter (inches) *4"*
- (2) total depth (feet) *310'*
- (3) static water level (feet) *45'* below top of ground.
- (4) casing *PVC*, *290'*
(material) (depth)
(size) If telescope see back.
- (5) screen *20'*, *290'*
(length) (depth to top)
4", *PVC*
(size) (material)
- (6) pump *5HP*, *75*
(HP) (yield gpm)
3/4
(type power)
- (7) electric log *no*
(yes or no)

(organization running log)

(8) how well bottom plugged
2" backwash valve
DRILLERS REMARKS: *17-B*


DEPT. OF NATURAL RESOURCES
BUREAU OF LAND & WATER RESOURCES

JUN 29 1984

RECEIVED

If well telescopes please sketch and show depths.

GROUND LEVEL

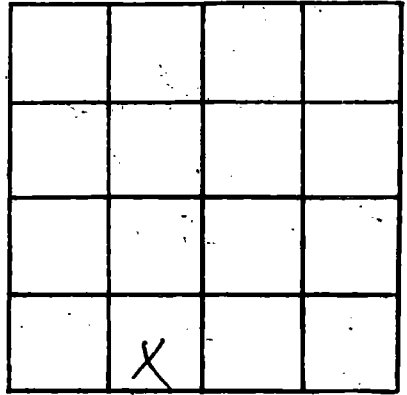

SECTION _____

Please indicate well location X.

ADDITIONAL INFORMATION

If more than one screen, show locations of each on sketch.