

MISSISSIPPI DEPARTMENT OF NATURAL RESOURCES

Bureau of Land and Water Resources

Southport Mall

P.O. Box 10631

Jackson, Mississippi 39209

WATER WELL DRILLERS LOG

CODED

HARRISON
M694
8/13/84

8/13/84
date well completed

Lyman Well Co.
firm name

Harrison
county well located

LANDOWNER: Shelton Bros.
P.O. Box 468
Biloxi, MS 39533
(mailing address)

description of formations encountered

from to

fill dirt & oyster shells	0	
blue clay	16	300
fine sand	301	340
Clay	341	620
sand fine	621	680
clay	681	820
sand - fine	821	920

WELL LOCATION:

sec. 28 T. 7 N R. 9 E
0 miles S of Biloxi
(distance) (direction) (nearest town)

WELL PURPOSE: Industrial
(home, irrigation, municipal, industrial)

WELL COMPLETION DATA:

- (1) diameter (inches) 8x6
- (2) total depth (feet) 910'
- (3) static water level (feet) 18 below above top of ground.
- (4) casing Black Top 850'
(material) (depth)
8x6 If telescope see back.
(size)
- (5) screen 60' 850'
(length) (depth to top)
6" Stainless Steel
(size) (material)
- (6) pump 30 400
(HP) (yield gpm)
electric - 3 phase
(type power)

(7) electric log yes
(yes or no)

Bureau of Geology
(organization running log)

(8) how well bottom plugged check Valve


DRILLERS REMARKS:

undreamed 22"

DEPT. OF NATURAL RESOURCES
BUREAU OF LAND & WATER RESOURCES

DEC 10 1984
RECEIVED

If well telescopes please sketch and show depths.

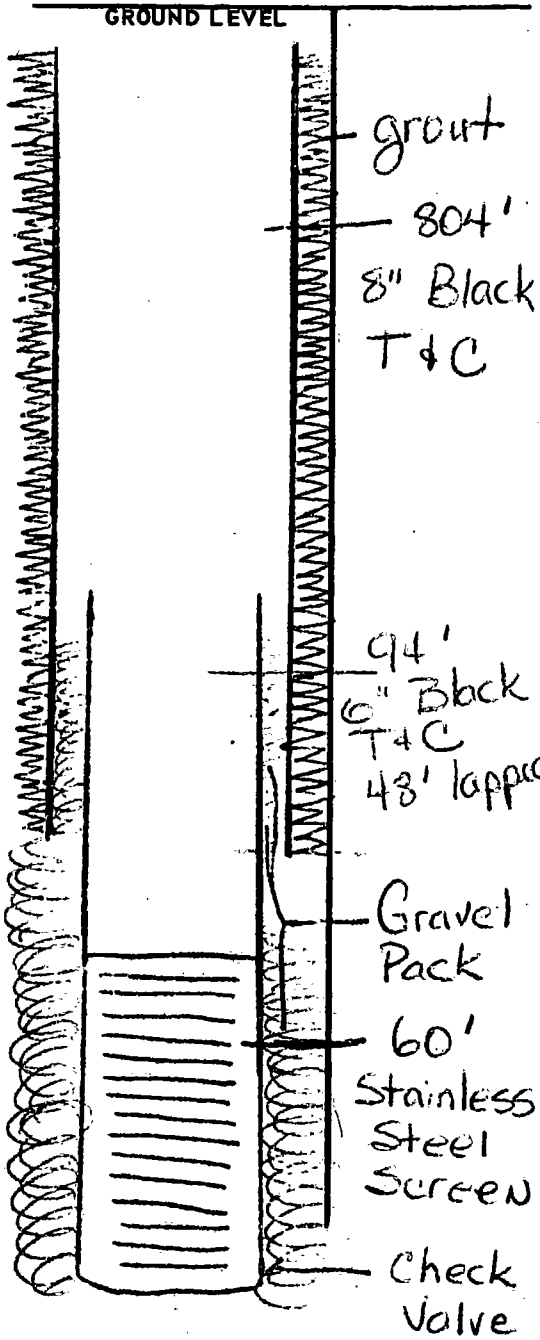

			4

SECTION 28

Please indicate well location X.

ADDITIONAL INFORMATION

If more than one screen, show locations of each on sketch.