

HARRISON

M696

8/14/84

8114

date well completed

65  
07134

MISSISSIPPI BOARD OF WATER COMMISSIONERS CODED

416 North State Street

Jackson, Mississippi 39201

WATER WELL DRILLERS LOG

84 Layne-Central Co.

firm name

Harrison

county well located

LANDOWNER:

City of Biloxi, Biloxi, MS

(mailing address)

WELL LOCATION:

sec 27 T 7 N R 9 E S W  
miles (distance) of (direction) (nearest town)

WELL PURPOSE:

municipal (home, irrigation, municipal, industrial)

WELL COMPLETION DATA:

- (1) diameter (inches) 16"
- (2) total depth (feet) 926'
- (3) static water level (feet) 22' below top of ground
- (4) casing (material) (depth) Steel 855'
- (5) screen (length) (depth to top) 60' 855'
- (6) pump (HP) (yield gpm) 75 800 electric (type power)
- (7) electric log (yes or no) yes MS Geo. Survey (organization running log)
- (8) how well bottom plugged Stainless Steel

description of formations encountered

from to

a schaly shelled	0	1
top sand	1	6
stiff blue sandy clay	6	48
loose sand w/clay	48	108
firm sand w/clay	108	142
blue clay - tough	142	295
hard sandy clay with	295	544
brittle clay - shale	544	589
sand w/clay	589	615
sandy shale - tough	615	682
sand str.	682	703
clay & sandy str.	703	731
sandy shale - tough	731	810
sandy shale - sandst	810	816
fine sand w/shale	816	829
fine sand w/shale	829	839
fine sand	839	861
fine sand	861	883
fine sand	883	893
wood-rotten & burnt	893	894
fine sand w/shale	894	906
fine sand w/shale	906	929
fine sand w/shale	929	940
sandy shale - tough str.	940	974


DEPT. OF NATURAL RESOURCES BUREAU OF LAND & WATER RESOURCES

SEP 27 1984 RECEIVED

DRILLERS REMARKS:

If well telescopes please sketch and show depths.

GROUND LEVEL

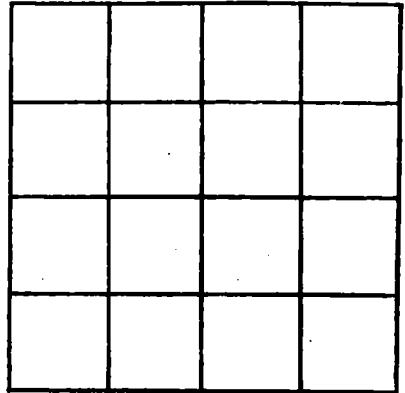

SECTION \_\_\_\_\_

Please indicate well location X.

ADDITIONAL INFORMATION

If more than one screen, show locations of each on sketch.