

HARRISON
M700

MISSISSIPPI DEPARTMENT OF NATURAL RESOURCES
Bureau of Land and Water Resources
Southport Mall
P.O. Box 10631
Jackson, Mississippi 39209

CODED

WATER WELL DRILLERS LOG
COASTAL DRILLING & SERVICE CO.

12/20/83 19 date well completed
ROUTE 1 BOX 618 firm name
Harrison county well located
Biloxi, MISS. 39532

LANDOWNER: Harrison Jones

description of formations encountered	from	to
top soil	1	3
Red Clay	3	15
Soft Blue Clay	15	210
fine water sand	210	220
good water sand	220	250

15504 Southport Rd

Biloxi, MS (mailing address)

WELL LOCATION:

sec 23 T 7 N R 9 E
D'Arville, (distance) miles (direction) (nearest town)

WELL PURPOSE: home (home, irrigation, municipal, industrial)

WELL COMPLETION DATA:

- (1) diameter (inches) 2"
- (2) total depth (feet) 250'
- (3) static water level (feet) 20 below top of ground
- (4) casing PVC 240' (material) (depth)
- (size) If telescope see back.
- (5) screen 10' 240' (length) (depth to top)
- 2" PVC (size) (material)
- (6) pump None 12 (HP) (yield gpm)
- Ele (type power)
- (7) electric log No (yes or no)

(organization running log)

(8) how well bottom plugged
2nd level plugged

DRILLERS REMARKS: 198

CODED


DEPT. OF NATURAL RESOURCES
BUREAU OF LAND & WATER RESOURCES

NOV 8 1984

RECEIVED

If well telescopes please sketch and show depths.

GROUND LEVEL

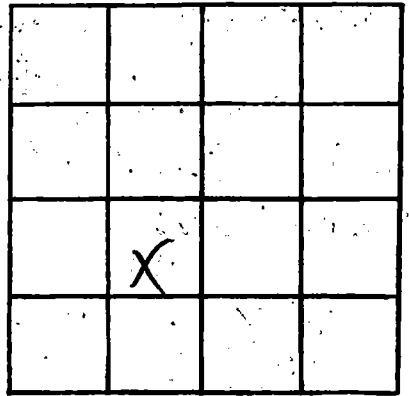

SECTION _____

Please indicate well location X.

ADDITIONAL INFORMATION

If more than one screen, show locations of each on sketch.