

MISSISSIPPI DEPARTMENT OF NATURAL RESOURCES

Bureau of Land and Water Resources

Southport Mall

P.O. Box 10631

Jackson, Mississippi 39209

WATER WELL DRILLERS LOG

COASTAL DRILLING & SERVICE CO.

CODED

HARRISON
M 701

3/2/84 19
date well completed

ROUTE 1 BOX 618
firm name

William
county well located

BILOXI MISS. 39532

LANDOWNER

Bill Leung
East Beach (Windward)
Biloki Drive
(mailing address)

description of formations encountered

description of formations encountered	from	to
white sand	1	15
soft blue clay	15	23
concrete sand	23	45
soft blue clay	45	60
gray sand	60	85
brown sand	85	120
concrete sand	120	145
soft blue clay	145	220
hard blue clay	220	370
firm water sand	370	410
firm water sand	410	470

WELL LOCATION:

sec. 28 T. 7 N. R. 9 E. S. 5 W.
On Ocean in Biloki
(distance) (direction) (nearest town)

WELL PURPOSE:

total (home, irrigation, municipal, industrial)

WELL COMPLETION DATA:

- (1) diameter (inches) 6" x 4"
- (2) total depth (feet) 470'
- (3) static water level (feet) 18' below top of ground.
- (4) casing steel, 450' (material) (depth)
6" x 4" (size) if telescope see back.
- (5) screen 20' (length), 450' (depth to top)
4" (size), SS (material)
- (6) pump 10HP (HP), 180 (yield gpm)
Eck (type power)
- (7) electric log yes (yes or no)

CODED

DEPT. OF NATURAL RESOURCES
BUREAU OF LAND & WATER RESOURCES

NOV 16 1984

RECEIVED

(organization running log)

(8) how well bottom plugged

4" lead with valve
DRILLERS REMARKS:

If well telescopes please sketch and show depths.


GROUND LEVEL

200'-10" Steel Top Casing

45' 6" Sched
Steel Casing

20'-4" A.C. SS
Screen

4" Leadwire Valve

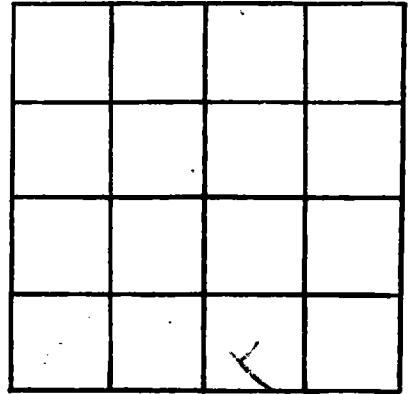

SECTION _____

Please indicate well location X.

ADDITIONAL INFORMATION

If more than one screen,
show locations of each on sketch.