

MISSISSIPPI DEPARTMENT OF NATURAL RESOURCES

Bureau of Land and Water Resources

Southport Mall

P.O. Box 10631

Jackson, Mississippi 39209

WATER WELL DRILLERS LOG

CODED

Harrison
M707
4/24/85

4-24 1985
date well completed

Mc Hill Well Works Harrison
firm name county well located

LANDOWNER: Byford K. Peden

Rt. 6 Box 138-69

Biloxi, Ms. 39532
(mailing address)

WELL LOCATION:

sec 9 T 7 N R 10 E
6 miles NW of Biloxi
(distance) (direction) (nearest town)

WELL PURPOSE:

(home, irrigation, municipal, industrial)

WELL COMPLETION DATA:

- (1) diameter (inches) 2"
- (2) total depth (feet) 500'
- (3) static water level (feet) 30' ^(below) _(above) top of ground.
- (4) casing Pvc Sch 40 490'
(material) (depth)

 If telescope see back.
(size)

- (5) screen 10' 490'
(length) (depth to top)
2" Sch 80 60 slot
(size) (material)

- (6) pump 1 8
(HP) (yield gpm)

Elec
(type power)

- (7) electric log
(yes or no)

(organization running log)

- (8) how well bottom plugged Sand
Shank

DRILLERS REMARKS:

description of formations encountered

from to

Mud/Sand	0	20
Sand/Gravel/Mud	20	40
Mud	40	60
Mud/Sand	60	80
Sand/Mud	80	100
Mud/Sand	100	120
Mud	120	160
Mud/Sand	160	180
Sand/Mud	180	200
Mud	200	260
Mud/Sand	260	280
Mud	280	300
Mud/Sand	300	320
Sand	320	340
Mud	340	440
Mud/Sand	440	460
Sand	460	500


RECEIVED

JUN - 4 1985

Department of Natural Resources
Bureau of Land & Water Resources

If well telescopes please sketch and show depths.

GROUND LEVEL

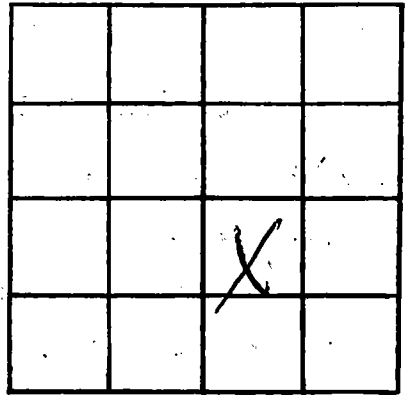

SECTION _____

Please indicate well location X.

ADDITIONAL INFORMATION

If more than one screen,
show locations of each on sketch.