

MISSISSIPPI DEPARTMENT OF NATURAL RESOURCES

Bureau of Land and Water Resources

Southport Mall

P.O. Box 10631

Jackson, Mississippi 39209

WATER WELL DRILLERS LOG

CODED

Harrison
M 708
5-9-85

5-9

1985

Mc Hill Well Works Harrison

date well completed

firm name

county well located

LANDOWNER:

James Bellmons

description of formations encountered

from

to

104 Lakeview Dr.

Sand

0 30

Biloxi, Ms. 39531
(mailing address)

WELL LOCATION:

sec 28 T 7 N R 10 E
6 miles W of Biloxi
(distance) (direction) (nearest town)

CODED

WELL PURPOSE:

(home, irrigation, municipal, industrial)

WELL COMPLETION DATA:

- (1) diameter (inches) 2"
- (2) total depth (feet) 30'
- (3) static water level (feet) 2' below top of ground
- (4) casing Sch 40 PVC 20' (material) (depth)

(size) If telescope see back.

- (5) screen 10' 20' (length) (depth to top)
1" bolt Sch 80 (size) (material)

- (6) pump 1/2 15 (HP) (yield gpm)

GLPC (type power)

- (7) electric log NO (yes or no)

(organization running log)

- (8) how well bottom plugged Sand
Shank

DRILLERS REMARKS:


RECEIVED

JUN 11 1985

Department of Natural Resources
Bureau of Land & Water Resources

If well telescopes please sketch and show depths.

GROUND LEVEL

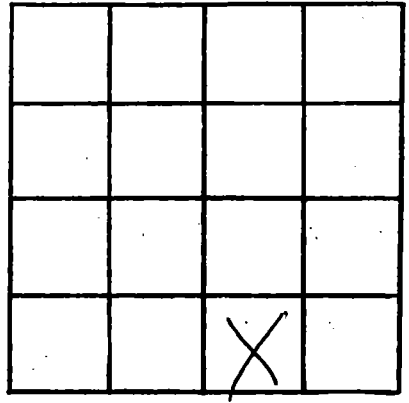

SECTION _____

Please indicate well location X.

ADDITIONAL INFORMATION

If more than one screen,
show locations of each on sketch.