

MISSISSIPPI DEPARTMENT OF NATURAL RESOURCES

Bureau of Land and Water Resources

Southport Mall

P.O. Box 10631

CODED

Jackson, Mississippi 39209

WATER WELL DRILLERS LOG

HARRISON
M 710

3-15-84 19 Lyman Well Co. Harrison
date well completed firm name county well located

Gulf Orleans, Ind
P.O. Box 283
Gulfport, MS 39502
(mailing address)

description of formations encountered	from	to
<u>Mud, Wood & Topsoil</u>	<u>0</u>	<u>8</u>
<u>Sand & Gravel</u>	<u>8</u>	<u>40</u>

WELL LOCATION:
sec. 5 T. 7 N. R. 9 E.
4 miles (S) of Biloxi
(distance) (direction) (nearest town)

<u>Blue Clay</u>	<u>40</u>	<u>280</u>
<u>Sand</u>	<u>280</u>	<u>332</u>

WELL PURPOSE: Sub-Division
(home, irrigation, municipal, industrial)

WELL COMPLETION DATA:

(1) diameter (inches) 8x6

(2) total depth (feet) 332'

(3) static water level (feet) 45' below above top of ground.

(4) casing Steel, 282'
(material) (depth)
8x6 if telescope see back.
(size)

(5) screen 50', 282'
(length) (depth to top)
6", Stainless
(size) (material)

(6) pump 25, 450
(HP) (yield gpm)
electric
(type power)

(7) electric log NO
(yes or no)
NO
(organization running log)

(8) how well bottom plugged backwash
Valve



RECEIVED

APR 9 1985

Department of Natural Resources
Bureau of Land & Water Resources

DRILLERS REMARKS:

If well telescopes please sketch and show depths.

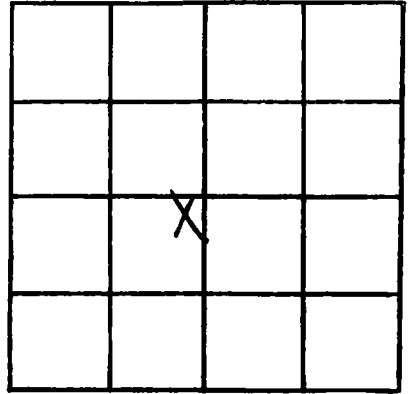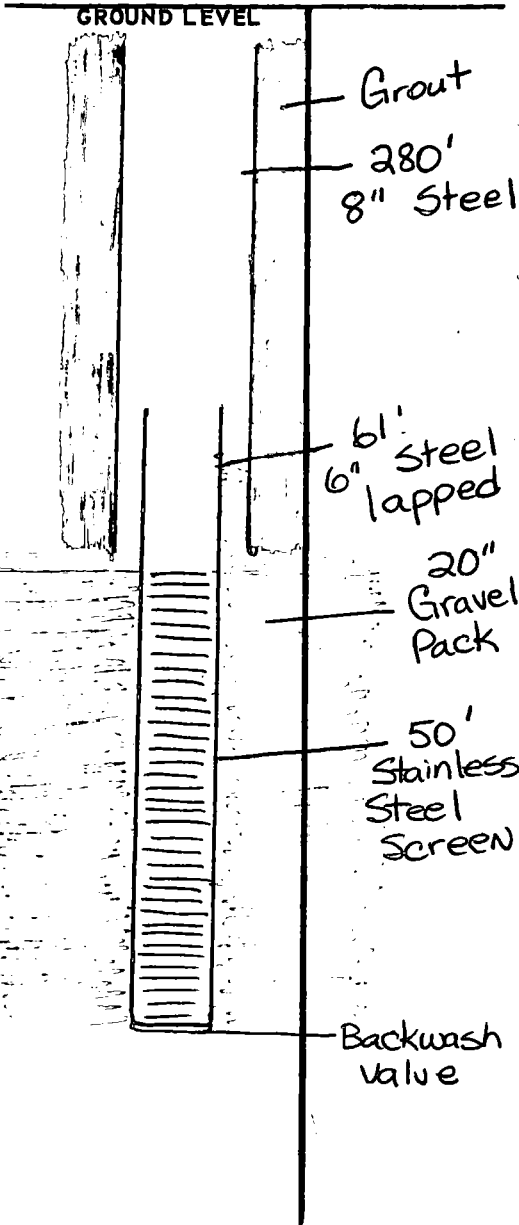

SECTION 5

Please indicate well location X.

ADDITIONAL INFORMATION

Horizontal lines for additional information.

If more than one screen, show locations of each on sketch.