

MISSISSIPPI DEPARTMENT OF NATURAL RESOURCES

Bureau of Land and Water Resources

Southport Mall

P.O. Box 10631

Jackson, Mississippi 39209

WATER WELL DRILLERS LOG

HARRISON
M 729
GW 11661

Caded

02/13

1990 Layne Central Co.

HARRISON

date well completed

firm name

county well located

LANDOWNER: City of Biloxi

P.O. Box 429

Biloxi, Miss. 39530

(mailing address)

WELL LOCATION: Kuhn St.

sec. 33 T 7 S R 9 W

(distance) miles (direction) of (nearest town)

WELL PURPOSE: Municipal
(home, irrigation, municipal, industrial)

WELL COMPLETION DATA:

- (1) diameter (inches) 18"
- (2) total depth (feet) 895'
- (3) static water level (feet) 29' below above top of ground.

(4) casing Steel 825'
(material) (depth)

18" If telescope see back.
(size) 68.7' & 10"

(5) screen 60.8' 766'
(length) (depth to top)

10" Stainless Steel
(size) (material)

(6) pump 75 800
(HP) (yield gpm)

Electric
(type power)

(7) electric log yes
(yes or no)

Layne-Central Co.
(organization running log)

(8) how well bottom plugged Value

description of formations encountered

from

to

Fill SAND	0'	8'
SANDY CLAY	8'	50'
Clay	50'	110'
SANDY CLAY	110'	240'
SAND	240'	250'
SHALE	250'	281'
SANDY SHALE	281'	316'
CLAY	316'	381'
SANDY CLAY	381'	516'
SAND	516'	536'
CLAY & SAND STRS.	536'	564'
SANDY CLAY	564'	593'
SAND & CLAY	593'	617'
CLAY	617'	641'
SANDY CLAY	641'	671'
SHALE	671'	758'
SANDY SHALE	758'	788'
SAND	788'	865'
CLAY	865'	906'

RECEIVED

OCT 25 1990


Department of Natural Resources
Bureau of Land & Water Resources

DRILLERS REMARKS:


Permit # MS-GW-11661

If well telescopes please sketch and show depths.

GROUND LEVEL

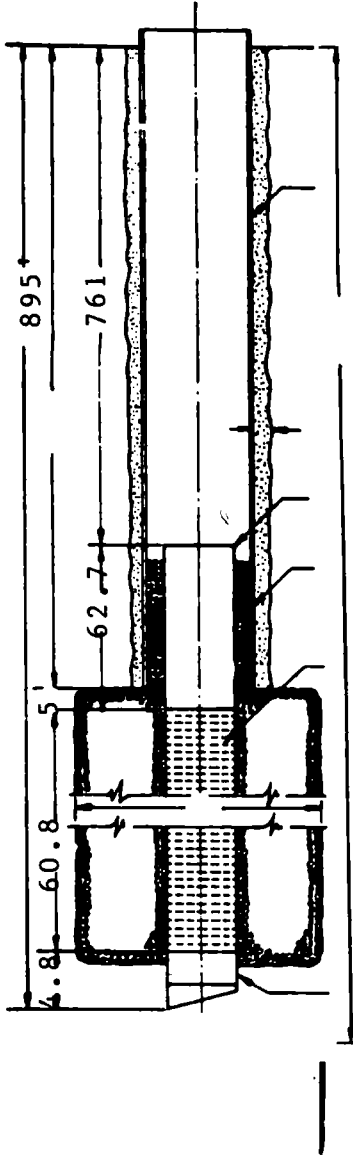

If more than one screen, show locations of each on sketch.

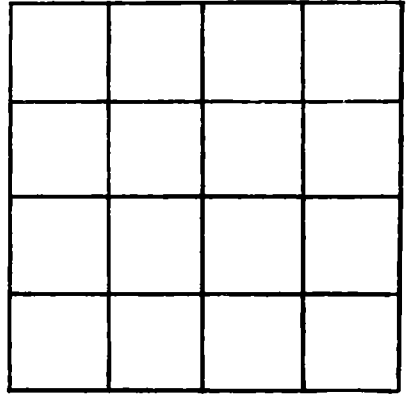

SECTION _____

Please indicate well location X.

ADDITIONAL INFORMATION

A series of horizontal lines for providing additional information.