

MISSISSIPPI DEPARTMENT OF ENVIRONMENTAL QUALITY  
Bureau of Land and Water Resources

P. O. Box 10631  
Jackson, MS 39289-0631  
WATER WELL DRILLERS LOG

COUNTY WELL LOCATED  
*Harrison*

WELL NUMBER CODED  
*M733* ✓

DATE WELL COMPLETED  
*5-7-90*

PERMIT NUMBER  
*12521*

NAME OF DRILLER  
**Coastal Drilling & Service Co.**  
*8456 Woolmarket Biloxi Road*  
**Biloxi, Mississippi 39532**

NAME & MAILING ADDRESS OF LANDOWNER  
*Sea Products*

*1747*  
*East Howard Ave.*

*Biloxi Ms. 39505*

WELL LOCATION: SEC TOWNSHIP RANGE  
*Harrison 34 7 N 9 E*

DISTANCE DIRECTION NEAREST TOWN  
Miles of *East Biloxi*

OTHER LANDMARK  
*Railroad Tracks*

WELL PURPOSE: Home, Irrigation, Municipal, Industrial, Fish Pond, etc.

PUMP DATA

PUMP TYPE (Circle One):  
Submersible, Turbine, Jet, Flowing Well,  
Other (Describe) \_\_\_\_\_

POWER TYPE (Circle One):  
Electric, Tractor, Diesel, Gasoline, Butane,  
Other (Describe) \_\_\_\_\_ H/P \_\_\_\_\_

Pump Capacity (GPM) No. of Stages Setting Depth FT.

PUMP TEST

Well yielded \_\_\_\_\_ GPM with  
a drawdown of \_\_\_\_\_ ft.  
after \_\_\_\_\_ hours of pumping

WELL DATA

Well *978* Casing Diameter (in.) *6"* Casing Length (Ft.) *918*

Type of Casing *S STEEL* Hole Depth *1978* Depth to Static Water Level *10'*

TYPE OF COMPLETION: (Circle One or More):  
Gravel Packed, Underreamed, Telescoped,  
Natural Development, Open Hole, Other  
(Describe) \_\_\_\_\_

Top of Lap Pipe or Reduction in Casing

FEET IF TELESCOPED OR MORE THAN ONE SCREEN: USE BACK PAGE

LOG DATA

TYPE OF LOG RUN (Circle One):  
No Log Run, Electric, Gamma Ray, Density, Sonic, Neutron,  
Other (Describe) \_\_\_\_\_

Name of Organization Running Log

SCREEN DATA

Diameter - Inches *4"* Length - Feet *60* Slot Size - Inches *.010*

Screen Type *Stainless* Depth, In. Bottom Feet *978*

GEOLOGIC DATA (Office Use Only)

Surface Elev.	Geologic Unit	Unit Thickness	Depth to Top


Subs. SWL Date Analysis Aquifer Test

Driller's Remarks

*Did not install pump*

DESCRIPTION OF FORMATIONS ENCOUNTERED	FROM	TO	FORMATIONS (Continued)	FROM
<i>top soil</i>	<i>1'</i>	<i>3'</i>		
<i>Red sand</i>	<i>3'</i>	<i>18'</i>		
<i>White sand</i>	<i>12'</i>	<i>30'</i>		
<i>soft Blue clay</i>	<i>30'</i>	<i>280'</i>		
<i>hard Blue clay</i>	<i>280'</i>	<i>440'</i>		
<i>fine water sand</i>	<i>440'</i>	<i>460'</i>		
<i>hard Blue clay</i>	<i>460'</i>	<i>940'</i>		
<i>fine water sand</i>	<i>940'</i>	<i>960'</i>		
<i>Coarse water sand</i>	<i>960'</i>	<i>978'</i>		

IF MORE SPACE IS NEEDED, USE BACK

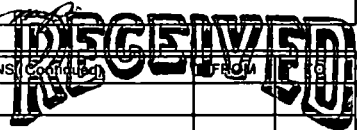

MAR 20 1992

Dept. of Environmental Quality  
Bureau of Land & Water Resources

If well telescopes please sketch and show depths.

GROUND LEVEL


SECTION \_\_\_\_\_

Please indicate well location X.

ADDITIONAL INFORMATION

\_\_\_\_\_

\_\_\_\_\_

Division

UNITED STATES DEPARTMENT OF THE INTERIOR  
BUREAU OF LAND MANAGEMENT

If more than one screen,  
show location of each on sketch.