

MISSISSIPPI DEPARTMENT OF ENVIRONMENTAL QUALITY

Office of Land and Water Resources

P. O. Box 10631
Jackson, MS 39289-0631
WATER WELL DRILLERS LOG

COUNTY WELL LOCATED <i>Harrison</i>	
WELL NUMBER <i>M 754</i>	CODED
DATE WELL COMPLETED <i>4-11-96</i>	

PERMIT NUMBER
NAME OF DRILLING FIRM <i>Coast Water Well Service</i>

NAME & MAILING ADDRESS OF LANDOWNER <i>Colville Jackson</i> <i>Whetstone Rd</i> <i>Biloxi, Ms</i>			
WELL LOCATION	SEC	TOWNSHIP	RANGE
	<i>7</i>	<i>7</i>	<i>9</i>
DISTANCE	DIRECTION	NEAREST TOWN	
<i>3</i> Miles	<i>North</i>	of <i>Biloxi</i>	
OTHER LANDMARK			
WELL PURPOSE <input checked="" type="checkbox"/> Home Irrigation, Municipal, Industrial, Fish Pond, etc.			

PUMP DATA			
PUMP TYPE (Circle One): <input checked="" type="checkbox"/> Submersible, Turbine, Jet, Flowing Well, Other (Describe) _____			
POWER TYPE (Circle One): <input checked="" type="checkbox"/> Electric, Tractor, Diesel, Gasoline, Butane, Other (Describe) _____ H/P <i>2</i>			
Pump Capacity (GPM) <i>27</i>	No. of Stages <i>10</i>	Setting Depth FT.	
PUMP TEST			
Well yielded _____ GPM with a drawdown of _____ ft. after _____ hours of pumping			

WELL DATA		
Well Depth <i>780'</i>	Casing Diameter (In.) <i>4x2"</i>	Casing Length (Ft.) <i>560'</i>
Type of Casing <i>PVC</i>	Hole Depth <i>780'</i>	Depth to Static Water Level <i>45'</i>

LOG DATA			
TYPE OF LOG RUN (Circle One): Electric, Gamma Ray, Density, Sonic, <input checked="" type="checkbox"/> Neutron, Other (Describe) _____			
Name of Organization Running Log			

TYPE OF COMPLETION: (Circle One or More): <input checked="" type="checkbox"/> Gravel Packed, Underreamed, Telescoped, <input checked="" type="checkbox"/> Natural Development, Open Hole, Other (Describe) _____			
---	--	--	--

GEOLOGIC DATA (Office Use Only)			
Surface Elev.	Geologic Unit	Unit Thickness	Depth to Top
Subs. SWL	Date	Analysis	Aquifer Test

WELL GROUTED TO A DEPTH OF <i>20</i> FEET Type Grout (circle one): Cement, Bentonite, or Mix

Driller's Remarks	
Top of Lap Pipe or Reduction in Casing	
FEET	IF TELESCOPED OR MORE THAN ONE SCREEN: USE BACK PAGE


SCREEN DATA		
Diameter - Inches <i>2"</i>	Length - Feet <i>20'</i>	Slot Size - Inches <i>.008</i>
Screen Type <i>PVC</i>	Depth to Bottom - Feet <i>780'</i>	

DESCRIPTION OF FORMATIONS ENCOUNTERED	FROM	TO	FORMATIONS (Continued)	FROM	TO
<i>Top Soil</i>	<i>0</i>	<i>2</i>	<i>Blue Clay streak sand shell</i>	<i>600</i>	<i>712</i>
<i>Orange Blue Clay</i>	<i>2</i>	<i>30</i>	<i>Med. coarse sand</i>	<i>712</i>	<i>780</i>
<i>Peagardul coarse sand</i>	<i>30</i>	<i>90</i>			
<i>Blue Clay streak sand</i>	<i>90</i>	<i>195</i>			
<i>Fine Med sand</i>	<i>195</i>	<i>230</i>			
<i>Blue Clay streak sand</i>	<i>230</i>	<i>334</i>			
<i>Med. coarse sand</i>	<i>334</i>	<i>360</i>			
<i>Blue Clay streak sand</i>	<i>360</i>	<i>475</i>			
<i>Fine Med sand</i>	<i>475</i>	<i>525</i>			
<i>Blue Clay</i>	<i>525</i>	<i>575</i>			
<i>low Med sand</i>	<i>575</i>	<i>600</i>			

MAY 24 1996

If well telescopes please sketch and show depths.

GROUND LEVEL

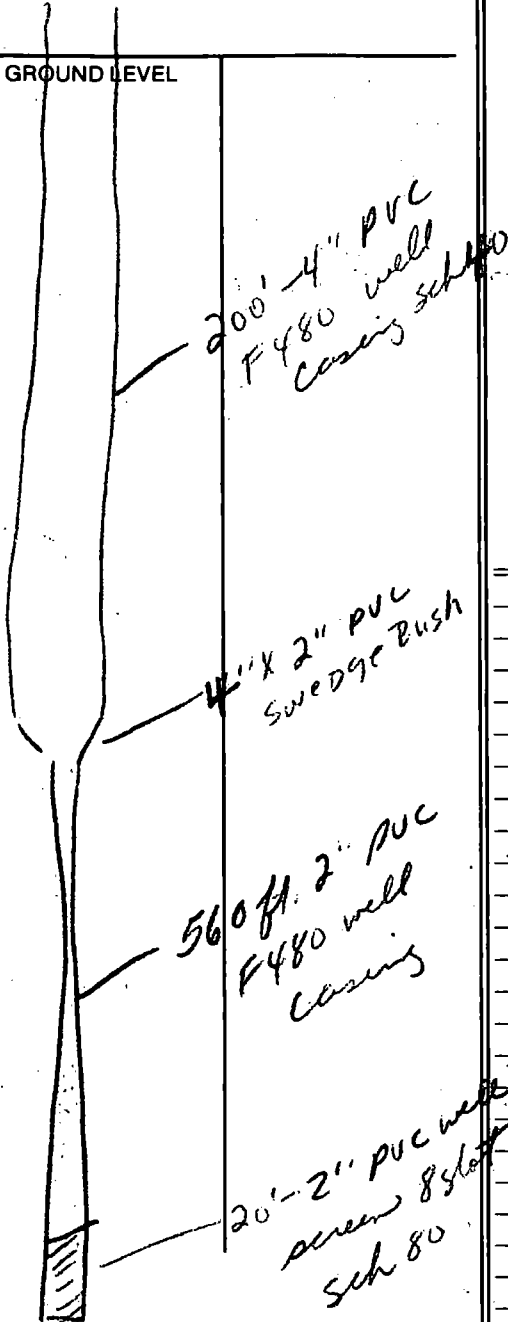

		X	

SECTION 7

Please indicate well location X.

ADDITIONAL INFORMATION

If more than one screen, show location of each on sketch.