

MISSISSIPPI DEPARTMENT OF ENVIRONMENTAL QUALITY

Office of Land and Water Resources

P. O. Box 10631
Jackson, MS 39289-0631

WATER WELL DRILLERS LOG

COUNTY WELL LOCATED HARRISON	
WELL NUMBER 1190	CODED <input checked="" type="checkbox"/>
DATE WELL COMPLETED 3-6-97	

PERMIT NUMBER 0404
NAME OF DRILLING FIRM LYMAN WELL CO.
GULFPORT, MS 39503

NAME & MAILING ADDRESS OF LANDOWNER COAST TO COAST SEAFOOD			
542 BAYVIEW			
BILOXI, MS 39532			
WELL LOCATION	SEC	TOWNSHIP	RANGE
	33	7	N 9 E
DISTANCE	DIRECTION		NEAREST TOWN
_____ Miles	_____ of _____		
OTHER LANDMARK			
WELL PURPOSE: Home, Irrigation, Municipal, <u>Industrial</u> , Fish Pond, etc.			

PUMP DATA		
PUMP TYPE (Circle One): Submersible, Turbine, Jet, Flowing Well, Other (Describe) <u>CENTRIFUGALS</u>		
POWER TYPE (Circle One): Electric, Tractor, Diesel, Gasoline, Butane, Other (Describe) <u>H/P</u>		
Pump Capacity (GPM) 250	No. of Stages	Setting Depth _____ FT.
PUMP TEST		
Well yielded <u>flowed</u> 250 GPM with a drawdown of _____ ft. after _____ hours of pumping		

WELL DATA		
Well Depth 1322	Casing Diameter (In.) 8"	Casing Length (Ft.) 1230
Type of Casing <u>Steel</u>	Hole Depth 1322	Depth to Static Water Level +16

LOG DATA	
TYPE OF LOG RUN (Circle One): <u>No Log Run</u> , Electric, Gamma Ray, Density, Sonic, Neutron, Other (Describe) _____	
Name of Organization Running Log	


TYPE OF COMPLETION: (Circle One or More): <u>Gravel Packed</u> , Underreamed, Telescoped, <u>Natural Development</u> , Open Hole, Other (Describe) _____			
WELL GROUTED TO A DEPTH OF 1230 FEET Type Grout (circle one): <u>Cement</u> , Bentonite, or Mix			

GEOLOGIC DATA (Office Use Only)			
Surface Elev.	Geologic Unit	Unit Thickness	Depth to Top
Subs. SWL	Date	Analysis	Aquifer Test

SCREEN DATA		
Diameter - Inches 6"	Length - Feet 50'	Slot Size - Inches .10
Screen Type SS wrap	Depth to Bottom - Feet 1322	

Driller's Remarks
Top of Lap Pipe or Reduction in Casing
IF TELESCOPED OR MORE THAN ONE SCREEN: USE BACK PAGE

DESCRIPTION OF FORMATIONS ENCOUNTERED	FROM	TO
fill shell trash	0	30
gray to blue clay	30	110
blue clay	110	530
fine sand	530	552
blue clay	552	865
sand fine	865	960
blue clay	960	1230
fine to medium sand	1230	1322

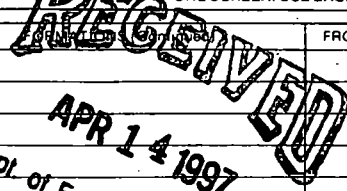

APR 14 1997

Dept. of Environmental Quality
Office of Land & Water Resources

IF MORE SPACE IS NEEDED, USE BACK

If well telescopes please sketch and show depths.

GROUND LEVEL

SECTION _____

Please indicate well location X.

ADDITIONAL INFORMATION

If more than one screen,
show location of each on sketch.

[Faint, illegible handwritten notes and stamps]