

MISSISSIPPI DEPARTMENT OF ENVIRONMENTAL QUALITY

Office of Land and Water Resources

P. O. Box 10631

Jackson, MS 39289-0631

WATER WELL DRILLERS LOG

COUNTY WELL LOCATED <u>HASLET</u>	
WELL NUMBER <u>M799</u>	CODED
DATE WELL COMPLETED <u>12/01/99</u>	

PERMIT NUMBER <u>0404</u>
NAME OF DRILLING FIRM <u>Lynan Well Co.</u>
<u>GULFPORT, MS 39503</u>

NAME & MAILING ADDRESS OF LANDOWNER <u>Williams Travel Center</u>			
<u>Cedar Lake + I-10</u>			
<u>Biloxi, ms 39532</u>			
WELL LOCATION	SEC	TOWNSHIP	RANGE
	<u>7</u>	<u>7</u>	<u>9</u>
DISTANCE	DIRECTION	NEAREST TOWN	
OTHER LANDMARK			
WELL PURPOSE. Home, Irrigation, <u>Municipal</u> Industrial, Fish Pond, etc.			

PUMP DATA		
PUMP TYPE (Circle One): Submersible, <u>Turbine</u> , Jet, Flowing Well, Other (Describe) _____		
POWER TYPE (Circle One): <u>Electric</u> , Tractor, Diesel, Gasoline, Butane, Other (Describe) _____ H/P <u>50</u>		
Pump Capacity (GPM) <u>700</u>	No. of Stages	Setting Depth <u>120</u> FT.
PUMP TEST		
Well yielded <u>700</u> GPM with a drawdown of <u>20</u> ft. after <u>12</u> hours of pumping		

WELL DATA		
Well Depth <u>810</u>	Casing Diameter (In.) <u>12"</u>	Casing Length (Ft.) <u>705'</u>
Type of Casing <u>steel</u>	Hole Depth <u>810</u>	Depth to Static Water Level

LOG DATA			
TYPE OF LOG RUN (Circle One): <u>Electric</u> , <u>Gamma Ray</u> , Density, Sonic, Neutron, Other (Describe) _____			
Name of Organization Running Log			

TYPE OF COMPLETION: (Circle One or More): <u>Gravel Packed</u> , <u>Underreamed</u> , Telescoped, Natural Development, Open Hole, Other	
(Describe) _____	
WELL GROUTED TO A DEPTH OF <u>715</u> FEET Type Grout (circle one): <u>Cement</u> Bentonite, or Mix	

GEOLOGIC DATA (Office Use Only)			
Surface Elev. <u>42'</u>	Geologic Unit	Unit Thickness	Depth to Top
Subs. SWL	Date	Analysis	Aquifer Test

SCREEN DATA		
Diameter - Inches <u>8"</u>	Length - Feet <u>80'</u>	Slot Size - Inches <u>10</u>
Screen Type <u>steel wrap</u>	Depth to Bottom - Feet <u>810'</u>	

Driller's Remarks

DESCRIPTION OF FORMATIONS ENCOUNTERED	FROM	TO
<u>0</u>	<u>0</u>	<u>25</u>
	<u>25</u>	<u>50</u>
	<u>50</u>	<u>455</u>
	<u>455</u>	<u>545</u>
	<u>545</u>	<u>710</u>
	<u>710</u>	<u>810</u>

FORMATION (continued)	FROM	TO
<u>Red clay</u>		
<u>top sand</u>		
<u>Blue clay</u>		
<u>sand</u>		
<u>Blue clay</u>		
<u>good sand</u>		


RECEIVED

JAN 20 2000

Dept. of Environmental Quality
Office of Land & Water Resources

IF MORE SPACE IS NEEDED, USE BACK

If well telescopes please sketch and show depths.

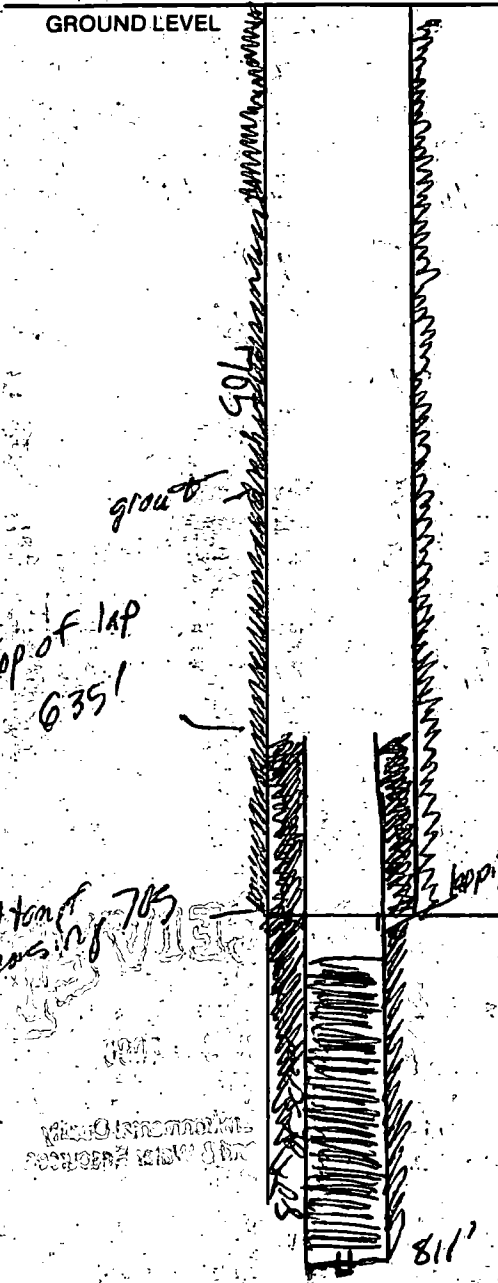

SECTION _____

Please indicate well location X.

ADDITIONAL INFORMATION

A series of horizontal lines for recording additional information.

If more than one screen, show location of each on sketch.

MISSISSIPPI DEPARTMENT OF ENVIRONMENTAL QUALITY
 Office of Land and Water Resources
 P. O. Box 2309
 Jackson, MS 39225
 Water Well Plugging/Decommissioning Form
 OLWR-DF-1 (04/08)
 (601)961-5555 (601)961-5228 (fax)



COUNTY WELL LOCATED: HARRISON		WELL NUMBER: M0799
PERMIT NUMBER:	DATE WELL PLUGGED: 02-20-2019	
NAME OF FIRM PLUGGING WELL: Thompson Brothers Drilling	TELEPHONE NUMBER: 601-425-0970	
NAME AND ADDRESS OF CURRENT LANDOWNER: Williams TRAVEL CENTER Loves Travel Center 11332 Cedar Lake Rd. Biloxi, MS 39532		
WELL LOCATION:	SECTION: 7	TOWNSHIP: 07S RANGE: 09W
	30.452778	88.935556
WELL LOCATION: LATITUDE: 30° 27' 10" N	LONGITUDE: 88° 56' 03" W	METHOD (Check ONE): <input type="checkbox"/> USGS QUAD <input type="checkbox"/> CONVENTIONAL SURVEY <input checked="" type="checkbox"/> GPS - HAND HELD OR SURVEY GRADE
DISTANCE:	DIRECTION:	NEAREST TOWN: BILOXI OTHER LANDMARK: LOVES TRAVEL CENTER
WELL PURPOSE (HOME, IRRIGATION, MUNICIPAL, ETC.): MUNICIPAL		
NAME OF WELL CONTRACTOR WHO DRILLED THE WELL: LYMAN WELL COMPANY		
NAME OF LANDOWNER WHEN WELL WAS DRILLED:		

WELL DATA			
WELL DEPTH: 810'	HOLE DEPTH: 810'		
CASING DIAMETER (IN.): 12	CASING LENGTH (FT.):	TYPE OF CASING: STEEL	
DEPTH TO STATIC WATER LEVEL: 57'	DATE WELL COMPLETED:		
WHY IS THE WELL BEING ABANDONED?			

DESCRIBE HOW THE WELL OR HOLE WAS PLUGGED (AMOUNT OF CASING AND/OR SCREEN THAT WAS REMOVED OR LEFT IN HOLE, MATERIAL AND AMOUNT USED IN PLUGGING, METHOD OF PLACING MATERIAL, ETC.)

Ran 2" tremie pipe to bottom of well. Pumped cement slurry to surface. Cut casing off below ground.

I CERTIFY THAT THE WELL WAS PLUGGED OR ABANDONED IN ACCORDANCE WITH THE STATE OF MISSISSIPPI REGULATIONS.

John W Thompson 0-679
 PRINT NAME MS LICENSE NUMBER
John W Thompson 2-25-19
 SIGNATURE DATE