

MISSISSIPPI DEPARTMENT OF ENVIRONMENTAL QUALITY

Office of Land and Water Resources

P. O. Box 10631

Jackson, MS 39289-0631

WATER WELL DRILLERS LOG

COUNTY WELL LOCATED  
Harrison

WELL NUMBER CODED  
M-812

Lakview Well

DATE WELL COMPLETED  
4/09/03

MSGW - 15800

PERMIT NUMBER  
0404

NAME OF DRILLING FIRM  
Lyman Well Co.

Subject M 39503

NAME & MAILING ADDRESS OF LANDOWNER  
City of Biloxi 140

Laneuse Street PO Box 429

Latitude: 35533  
Longitude:

WELL LOCATION: SEC 28 TOWNSHIP 7 N RANGE 10 E

DISTANCE DIRECTION NEAREST TOWN

Miles of

OTHER LANDMARK

WELL PURPOSE: Home, Irrigation, Municipal, Industrial, Fish Pond, etc.

PUMP DATA

PUMP TYPE (Circle One):  
Submersible, Turbine, Jet, Flowing Well,  
Other (Describe)

POWER TYPE (Circle One):  
Electric, Tractor, Diesel, Gasoline, Butane,  
Other (Describe) H/P 100

DESCRIPTION OF FORMATIONS ENCOUNTERED	FROM	TO
tan sand	0	100
blue clay	100	243
sand	243	290
blue clay	290	390
rustic sand	390	410
blue clay	410	630
coarse sand	530	605
blue brown clay	605	722
fine sand	722	830
blue clay	830	890
sand	890	950

WELL DATA

Well Depth 950 Casing Diameter (In.) 20" Casing Length (Ft.) 730

Type of Casing steel Hole Depth 950 Depth to Static Water Level 51'

TYPE OF COMPLETION: (Circle One or More):  
Gravel Packed, Underreamed, Telescoped,  
Natural Development, Open Hole, Other

WELL GROUTED TO A DEPTH OF 730 FEET  
Type Grout (circle one): Cement, Bentonite, or Mix

SCREEN DATA

Diameter - Inches 10" Length - Feet 140 Slot Size - Inches .012

Screen Type SS wrap Depth to Bottom - Feet 950

Top of Lap Pipe or Reduction in Casing  
600 FEET

IF TELESCOPED OR MORE THAN ONE SCREEN: USE BACK PAGE

RECEIVED

MAY 01 2003

BY: OLWR

I certify that the well was drilled, constructed and completed in accordance with all applicable Requirements of the Mississippi Department of Environmental Quality and/or the Mississippi Department of Health regulations and state laws.


John Padua 0-640  
Signature of Licensed Driller and License No.

4/09/03  
Date

Additional Information Required On Back

If well telescopes please sketch and show depths.

GROUND LEVEL

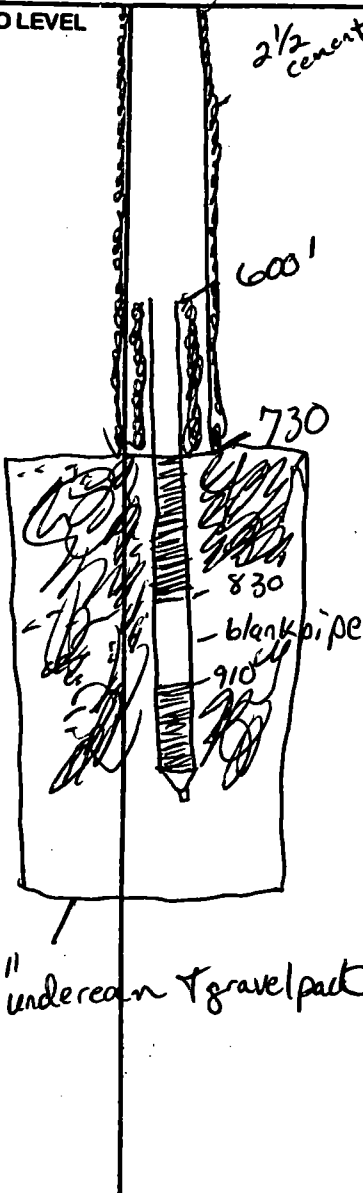

36" under screen gravel pack


SECTION \_\_\_\_\_

Please indicate well location X.

Pump Capacity (GPM)	No. of Stages	Setting Depth	FT.
---------------------	---------------	---------------	-----

PUMP TEST

Well yielded 2300 GPM with  
 a drawdown of 45 ft.  
 after 24 hours of pumping

LOG DATA

TYPE OF LOG RUN (Circle One): No Log Run,  
 Electric, Gamma Ray, Density, Sonic, Neutron,  
 Other (Describe) \_\_\_\_\_

Name of Organization Running Log \_\_\_\_\_

GEOLOGIC DATA (Office Use Only)

Surface Elev.	Geologic Unit	Unit Thickness	Depth to Top
Subs. SWL	Date	Analysis	Aquifer Test

Driller's Remarks

If more than one screen,  
 show location of each on sketch.