

MISSISSIPPI DEPARTMENT OF ENVIRONMENTAL QUALITY

Office of Land and Water Resources

P. O. Box 10631
Jackson, MS 39289-0631
WATER WELL DRILLERS LOG

COUNTY WELL LOCATED <i>Harrison</i>	
WELL NUMBER <i>M-814</i>	CODED
DATE WELL COMPLETED <i>June 29</i>	

PERMIT NUMBER <i>M + M well</i>
NAME OF DRILLING FIRM <i>8827 Boss Hensley Biloxi Rd</i>

NAME & MAILING ADDRESS OF LANDOWNER <i>Charlie Brown 9194 Pine crest Biloxi</i>			
Latitude:			
Longitude:			
WELL LOCATION	SEC	TOWNSHIP	RANGE
	<i>5</i>	<i>7</i>	<i>10</i> ^N _E
DISTANCE	DIRECTION	NEAREST TOWN	
<i>1/2</i> Miles	<i>south</i>	of <i>Wooducht</i>	
OTHER LANDMARK <i>1/8 mile from Wooducht Gro.</i>			
WELL PURPOSE: Home, Irrigation, Municipal, Industrial, Fish Pond, etc. <i>Home</i>			

PUMP DATA			
PUMP TYPE (Circle One): <input checked="" type="checkbox"/> Submersible, <input type="checkbox"/> Turbine, <input type="checkbox"/> Jet, <input type="checkbox"/> Flowing Well, Other (Describe) _____			
POWER TYPE (Circle One): <input checked="" type="checkbox"/> Electric, <input type="checkbox"/> Tractor, <input type="checkbox"/> Diesel, <input type="checkbox"/> Gasoline, <input type="checkbox"/> Butane, Other (Describe) _____ H/P <i>1</i>			

DESCRIPTION OF FORMATIONS ENCOUNTERED	FROM	TO
<i>Orange clay</i>	<i>0-20</i>	
<i>sand</i>	<i>20-40</i>	
<i>gray clay</i>	<i>40-150</i>	
<i>green clay</i>	<i>150-290</i>	
<i>course sand</i>	<i>290-325</i>	

WELL DATA		
Well Depth <i>325</i>	Casing Diameter (In.) <i>4x2</i>	Casing Length (Ft.) <i>310</i>
Type of Casing <i>PVC</i>	Mole Depth <i>325</i>	Depth to Static Water Level <i>40 feet</i>
TYPE OF COMPLETION: (Circle One or More): <input checked="" type="checkbox"/> Gravel Packed, <input type="checkbox"/> Underreamed, <input type="checkbox"/> Telescoped, <input checked="" type="checkbox"/> Natural Development, <input type="checkbox"/> Open Hole, <input type="checkbox"/> Other (Describe) _____		

WELL GROUTED TO A DEPTH OF <i>10</i> FEET
Type Grout (circle one): Cement, Bentonite, or Mix

SCREEN DATA		
Diameter - inches <i>2"</i>	Length - Feet <i>15</i>	Slot Size - inches <i>1006</i>
Screen Type <i>PVC</i>	Depth to Bottom - Feet <i>310-325</i>	

RECEIVED	
<i>JUL 17 2003</i>	
BY: OLWR	
Top of Lap Pipe or Reduction in Casing	
FEET	IF TELESCOPED OR MORE THAN ONE SCREEN: USE BACK PAGE

I certify that the well was drilled, constructed and completed in accordance with all applicable Requirements of the Mississippi Department of Environmental Quality and/or the Mississippi Department of Health regulations and state laws.


Jle Madden 0563
Signature of Licensed Driller and License No.

July 14, 03
Date

Additional Information Required On Back

If well telescopes please sketch and show depths.

GROUND LEVEL

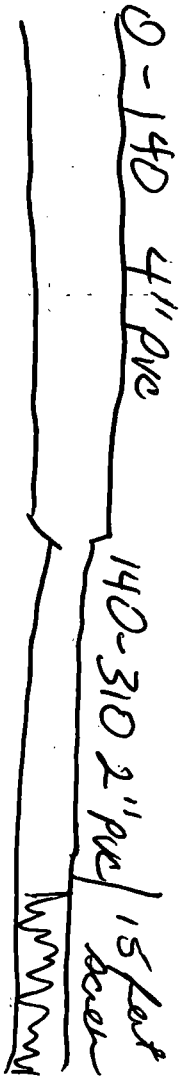

	X		

SECTION 5

Please indicate well location X.

Pump Capacity (GPM)	No. of Stages	Setting Depth
20	9	80 - FT.

PUMP TEST

Well yielded 35 GPM with
 a drawdown of _____ ft.
 after _____ hours of pumping

LOG DATA

TYPE OF LOG RUN (Circle One): No Log Run, Electric, Gamma Ray, Density, Sonic, Neutron, Other (Describe) _____

Name of Organization Running Log _____

GEOLOGIC DATA (Office Use Only)

Surface Elev.	Geologic Unit	Unit Thickness	Depth to Top
Subs. SWL	Date	Analysis	Aquifer Test

Driller's Remarks

If more than one screen, show location of each on sketch.