

MISSISSIPPI DEPARTMENT OF ENVIRONMENTAL QUALITY

Office of Land and Water Resources

P. O. Box 10631
Jackson, MS 39289-0631
WATER WELL DRILLERS LOG

COUNTY WELL LOCATED Harrison	
WELL NUMBER N-817	CODED
DATE WELL COMPLETED 9-11-03	

PERMIT NUMBER
NAME OF DRILLING FIRM Coast Water Well Service

NAME & MAILING ADDRESS OF LANDOWNER Tom Brasig (MAIL) 1174 Glen Dale Pl.			
Latitude: Boyet RD			
Longitude: Woolmarket MS			
WELL LOCATION	SEC	TOWNSHIP	RANGE
	4	7	10
DISTANCE	DIRECTION	NEAREST TOWN	
1/2	-	Woolmarket	
OTHER LANDMARK			
WELL PURPOSE: <input checked="" type="radio"/> Home Irrigation, <input type="radio"/> Municipal, <input type="radio"/> Industrial, <input type="radio"/> Fish Pond, etc.			

PUMP DATA	
PUMP TYPE (Circle One): <input checked="" type="radio"/> Submersible, <input type="radio"/> Turbine, <input type="radio"/> Jet, <input type="radio"/> Flowing Well, Other (Describe) _____	
POWER TYPE (Circle One): <input checked="" type="radio"/> Electric, <input type="radio"/> Tractor, <input type="radio"/> Diesel, <input type="radio"/> Gasoline, <input type="radio"/> Butane, Other (Describe) _____ H/P 1/2	

DESCRIPTION OF FORMATIONS ENCOUNTERED	FROM	TO
TOP SOIL	0	2
Orange Clay	2	20
White coarse sand	20	35
White Clay	35	39
White Coarse Sand	59	73
Blue clay	73	305
medium + Coarse Sand	305	328
Blue clay	328	400
Grey coarse sand	400	480
Blue clay	480	650
Medium + Coarse Sand	650	750

WELL DATA		
Well Depth 750'	Casing Diameter (in.) 4" X 2"	Casing Length (ft) 540' X 4" 510' X 2"
Type of Casing PVC	Hole Depth 750'	Depth to Static Water Level 50'
TYPE OF COMPLETION: (Circle One or More): <input checked="" type="radio"/> Gravel Packed, <input type="radio"/> Underreamed, <input type="radio"/> Telescoped, <input checked="" type="radio"/> Natural Development, <input type="radio"/> Open Hole, <input type="radio"/> Other (Describe)		
WELL GROUTED TO A DEPTH OF 10 FEET Type Grout (circle one): <input checked="" type="radio"/> Cement, <input type="radio"/> Bentonite, or <input type="radio"/> Mix		

SCREEN DATA		
Diameter - inches 2"	Length - Feet 20'	Slot Size - inches .008
Screen Type PVC	Depth to Bottom - Feet 750'	

Top of Lap Pipe or Reduction in Casing
FEET <input type="checkbox"/> IF TELESCOPED OR MORE THAN ONE SCREEN: USE BACK PAGE

RECEIVED
SEP 21 2003
BY: OLWR


I certify that the well was drilled, constructed and completed in accordance with all applicable Requirements of the Mississippi Department of Environmental Quality and/or the Mississippi Department of Health regulations and state laws.

Jack Rydell 472
Signature of Licensed Driller and License No.

9/19/03
Date

Additional Information Required On Back

If well telescopes please sketch and show depths.

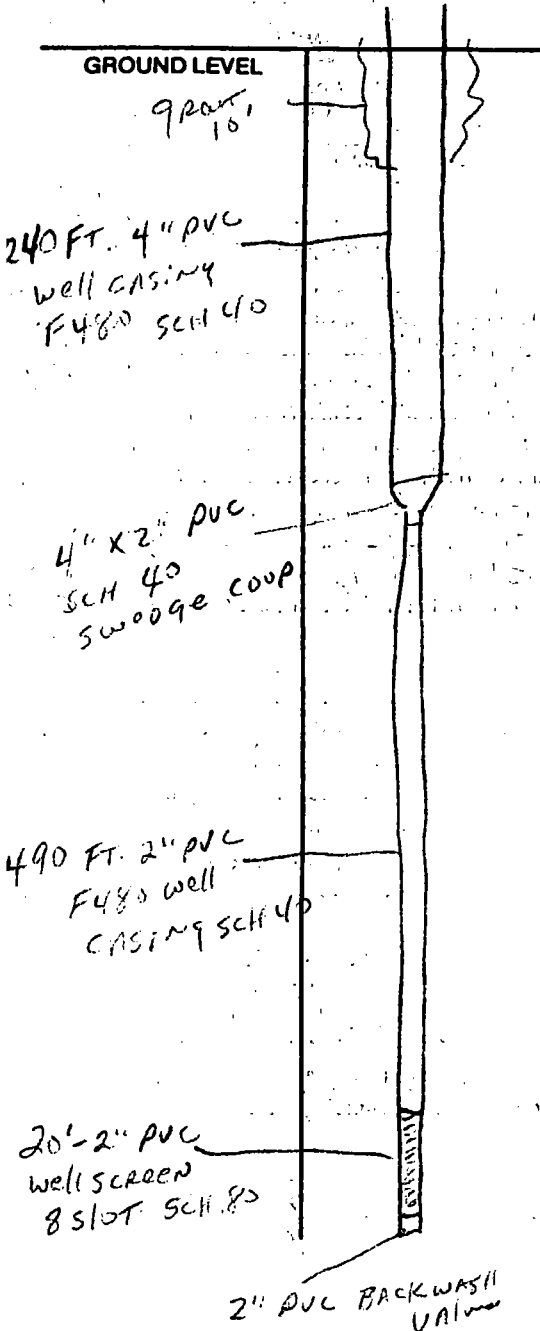

If more than one screen, show location of each on sketch.

X			

SECTION 4

Please indicate well location X.

Pump Capacity (GPM)	No. of Stages	Setting Depth
19	10	120 FT.
PUMP TEST		
Well yielded _____ GPM with a drawdown of _____ ft. after _____ hours of pumping		

LOG DATA

TYPE OF LOG RUN (Circle One):
 Electric, Gamma Ray, Density, No Log Run, Sonic, Neutron, Other (Describe) _____

Name of Organization Running Log _____

GEOLOGIC DATA (Office Use Only)

Surface Elev.	Geologic Unit	Unit Thickness	Depth to Top
Subs. SWL	Date	Analysis	Aquifer Test

Driller's Remarks

