	J State V	Well Report	For Office Use Only:				
County: HARRISON		Part 1	Aquifer:				
		nent of Environmental Quality	11 926				
Permit #:		d and Water Resources D. Box 10631	Well #: <u>M-935</u>				
Driller: LAYNE-CENTRAL		, MS 39289-0631	L. S. Elevation:				
		01) 961-5210					
Date Drilling Completed: 9/14/04 (601)		354-6938 (fax)	E-Lot #:				
State Law requires that this report 30 days of completion of drilling of	of the well.						
Well Owner Information		Well Location					
Owner Name KEESLER AIR FORCE BASE		Latitude: 30 ° 24 ' 088 " Longitude: 088 ° 55 ' 067					
Mailing Address: 81 CONS/LGCA		Method of Lat/Long (circle one): Conventional Survey					
310 M STREET, ROOM 102		USGS quad, Hand-Held GPS, Survey-grade GPS					
KEESLER AFB, MS	38534-2102	1/4 1/4 Sec 19	Twn 7S Rng 9W				
City State	Zip Code						
		Distance Direction					
Telephone No. (<u>228</u>) <u>377-1820</u>		Miles	of KEESLER AFB				
	Well	Data					
Purpose of Well (circle one) Home	Industrial Public Sector	upply Irrigation Fish Cult	ure Other:				
Date well drilling started:	8/16/04	Date well drilling completed:	9/14/04				
If flowing, method of flow regulation:	Valve	Other (describe)					
Hole depth: 615' Well depth: 586' Well grouted to a depth of 520 feet							
	Cement	Bentonite	Mix				
		Bentonite 18 inches Type of					
Casing length: 520 feet		18 inches Type of					
Type of grout(circle one)Casing length:520feetScreen length:60feetScreen slot size:0.024inches	Casing diameter:	18 inches Type of	casing: STEEL				
Casing length:520feetScreen length:60feetScreen slot size:0.024inches	Casing diameter:	18inchesType of12inchesType ofetting depth:From526	casing: STEEL screen: WIRE-WRAPPED feet to 586 feet				
Casing length:520feetScreen length:60feetScreen slot size:0.024inches	Casing diameter: Screen diameter: Gravel Packed Un	18inchesType of12inchesType ofetting depth:From526	casing: STEEL screen: WIRE-WRAPPED				
Casing length:520feetScreen length:60feetScreen slot size:0.024inchesType of completion(circle all applicable):	Casing diameter: Screen	18 inches Type of 12 inches Type of etting depth: From 526 derreamed Telescoped Ope	casing: STEEL screen: WIRE-WRAPPED feet to 586 feet n Hole Natural Development				
Casing length: 520 feet Screen length: 60 feet Screen slot size: 0.024 inches Type of completion (circle all applicable): Top of lap pipe or reduction in casing:	Casing diameter: Screen	18inchesType of12inchesType ofetting depth:From526	casing: STEEL screen: WIRE-WRAPPED feet to 586 feet n Hole Natural Development				
Casing length: 520 feet Screen length: 60 feet Screen slot size: 0.024 inches Type of completion (circle all applicable): Top of lap pipe or reduction in casing:	Casing diameter: Screen diameter: Gravel Packed Un Other (describe): 440 feet	18 inches Type of 12 inches Type of etting depth: From 526 derreamed Telescoped Ope	casing: STEEL screen: WIRE-WRAPPED feet to 586 feet to 586 n Hole Natural Development streen, describe on back of page.				
Casing length: 520 feet Screen length: 60 feet Screen slot size: 0.024 inches Type of completion (circle all applicable): Top of lap pipe or reduction in casing:	Casing diameter: Screen	18 inches Type of 12 inches Type of etting depth: From 526 derreamed Telescoped Ope - - - If telescoped or more than one so Neutror	casing: STEEL screen: WIRE-WRAPPED feet to 586 feet to 586 n Hole Natural Development streen, describe on back of page.				
Casing length: 520 feet Screen length: 60 feet Screen slot size: 0.024 inches Type of completion (circle all applicable): Top of lap pipe or reduction in casing:	Casing diameter: Screen diameter: Screen diameter: Gravel Packed Un Other (describe): 440 feet. run Electric Gamma YNE-CENTRAL, JAC tructed and completed	18 inches Type of 12 inches Type of 2 inches Type of 2 inches Type of 2 from 526 3 derreamed Telescoped 4 ft telescoped or more than one sc 4 Ray Density 5 Sonic Neutror KSON, MS in accordance with applicable	casing: STEEL screen: WIRE-WRAPPED				
Casing length: 520 feet Screen length: 60 feet Screen slot size: 0.024 inches Type of completion (circle all applicable): Top of lap pipe or reduction in casing:	Casing diameter: Screen diameter: Screen diameter: Gravel Packed Un Other (describe): 440 feet. run Electric Gamma YNE-CENTRAL, JAC tructed and completed	18 inches Type of 12 inches Type of 2 inches Type of 2 inches Type of 2 from 526 3 derreamed Telescoped 4 ft telescoped or more than one sc 4 Ray Density 5 Sonic Neutror KSON, MS in accordance with applicable	casing: STEEL screen: WIRE-WRAPPED				
Casing length: 520 feet Screen length: 60 feet Screen slot size: 0.024 inches Type of completion (circle all applicable): Top of lap pipe or reduction in casing: Logs run (circle all applicable): No log r Name of organization running log(s): LA I certify that the well was drilled, const	Casing diameter: Screen diameter: Screen diameter: Gravel Packed Un Other (describe): 440 feet. run Electric Gamma YNE-CENTRAL, JAC tructed and completed	18 inches Type of 12 inches Type of 2 inches Type of 2 inches Type of 2 from 526 3 derreamed Telescoped 4 ft telescoped or more than one sc 4 Ray Density 5 Sonic Neutror KSON, MS in accordance with applicable	casing: STEEL screen: WIRE-WRAPPED feet to 586 feet to 586 n Hole Natural Development creen, describe on back of page. n Other:				
Casing length: 520 feet Screen length: 60 feet Screen slot size: 0.024 inches Type of completion (circle all applicable): Top of lap pipe or reduction in casing:	Casing diameter: Screen diameter: Screen diameter: Gravel Packed Un Other (describe): 440 feet. run Electric Gamma YNE-CENTRAL, JAC tructed and completed	18 inches Type of 12 inches Type of 2 inches Type of 2 inches Type of 2 from 526 3 derreamed Telescoped 4 ft telescoped or more than one sc 4 Ray Density 5 Sonic Neutror KSON, MS in accordance with applicable	casing: STEEL screen: WIRE-WRAPPED feet to 586 feet to 586 n Hole Natural Development creen, describe on back of page. n Other: requirements of the Mississipp				
Casing length: 520 feet Screen length: 60 feet Screen slot size: 0.024 inches Type of completion (circle all applicable): Top of lap pipe or reduction in casing:	Casing diameter: Screen diameter: Screen diameter: Gravel Packed Un Other (describe): 440 feet. run Electric Gamma YNE-CENTRAL, JACI tructed and completed d/or the Mississippi Dep	18 inches Type of 12 inches Type of 2 inches Type of 2 inches Type of 2 from 526 derreamed Telescoped Ope - - - If telescoped or more than one sc - a Ray Density Sonic Neutron KSON, MS in accordance with applicable artment of Health regulations and	casing: STEEL screen: WIRE-WRAPPED feet to 586 feet to 586 n Hole Natural Development creen, describe on back of page. n Other:				
Casing length: 520 feet Screen length: 60 feet Screen slot size: 0.024 inches Type of completion (circle all applicable): inches Top of lap pipe or reduction in casing:	Casing diameter: Screen diame	18 inches Type of 12 inches Type of 2 inches Type of 2 inches Type of 2 from 526 3 derreamed Telescoped 4 derreamed Telescoped 4 ft telescoped or more than one sc 5 Ray Density 5 Sonic Neutron KSON, MS In accordance with applicable artment of Health regulations and Dawe	casing: STEEL screen: WIRE-WRAPPED feet to 586 feet n Hole Natural Development recen, describe on back of page. N Other:				
Casing length: 520 feet Screen length: 60 feet Screen slot size: 0.024 inches Type of completion (circle all applicable): inches Top of lap pipe or reduction in casing:	Casing diameter: Screen diame	18 inches Type of 12 inches Type of 2 inches Type of 2 inches Type of 2 from 526 3 derreamed Telescoped 4 derreamed Telescoped 4 ft telescoped or more than one sc 5 Ray Density 5 Sonic Neutron KSON, MS In accordance with applicable artment of Health regulations and Dawe	casing: STEEL screen: WIRE-WRAPPED feet to 586 feet m Hole Natural Development recen, describe on back of page. M Other: requirements of the Mississipp d state laws.				

. A

.


BA: OTMB

M- 935

If well telescopes, please sketch below and show depths.

Ground level	Description of Formations Encountered	From	То
	SAND	0	2
•	CLAY / SAND STREAKS	22	6
•	SAND / BLUE CLAY STREAKS	60	20
	BLUE CLAY	200	31
	BLUE CLAY / SAND STREAKS	310	41
	SAND / CLAY STREAKS	415	54
	SAND	548	61
			-
			· · · ·

If more than one screen, show location of each on sketch.

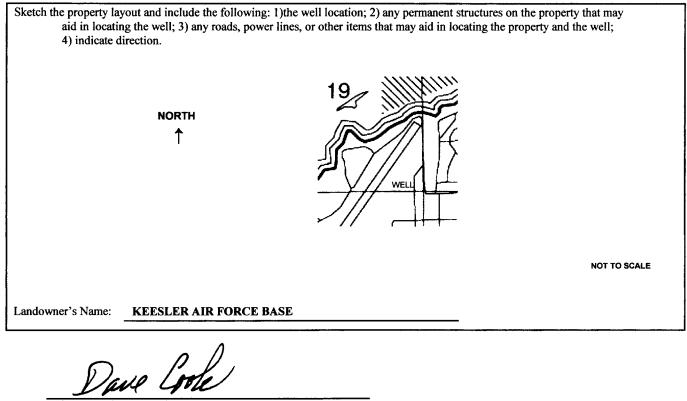

Signature of Water Well Contractor

State well Report							
County: HAR	RISON		Part 2 r's Completion Report ent of Environmental Quali	For Office Use Only:			
Permit #:			and Water Resources	Aquifer:			
P. O		. Box 10631	Well #: M-935				
		MS 39289-0631 1) 961-5210	Well #: _// - / 35				
		54-6938 (fax) Elevation:					
This report should be prepared by the pump installer in detail and filed with the Department within 30 days of the installation of pump.							
	ll Owner Informati	on	Well Location				
Owner Name KEESLER AIR FORCE BASE		Latitude: 30 ° 24 ' 088 " Longitude: 088 ° 55 ' 067 "					
Mailing Address: 81 CONS/LGCA		Latitude: 30 ° 24 ' 088 " Longitude: 088 ° 55 ' 067 " Method of Lat/Long (circle one): Conventional Survey					
310 M STREET, ROOM 102		USGS quad, Hand-Held GPS, Survey-grade GPS					
KEE	SLER AFB, MS	38534-2102	1/4 1/4 Sec	19 Twn 7S Rng 9W			
City	State	Zip Code					
Talanhana Na (229) 255 1020			rection Nearest Town			
Telephone No. (228) 377-1820		Miles	of KEESLER AFB			
Pump Type Power Type							
	Circle One			Circle One			
Air Lift	Jet	Submersible	Diesel Engine Ga	soline Engine Natural Gas			
Bucket	Piston	Turbine	Electric Motor	Hand Tractor PTO			
Centrifugal	Rotary	Flowing Well	Windmill	Other (specify):			
Other (specify):		Horse Power Rating of Motor: 125					
Date Pump Installed:	12/8/04		Setting Depth:	224 feet			
Rated Pump Capacity -	1200	Gallons Per Minute	Number of Stages:	5			
Pump Test Data			Method of Measuring Water Level Circle One				
Date Well Tested:	4/27/05		Air Line Electri	c Measuring Line Steel Tape			
Static Water Level (A):	72 Fee	t Below Land Surface	Other (specify):				
Pumping Water Level (B)): <u>60</u> Fee	t Below Land Surface					
Drawdown [(B) - (A)]: 12 Feet Below Land Surface			For flowing well, measured shut in head: feet				
Test Pumping Rate:	1246	Gallons Per Minute	Well yielded 1246	GPM with a drawdown of			
Duration of Pump Test (minimum 4 hours):6 hours			feet after	6 hours of pumping			
I hereby certify that the above statements are true to the best of my knowledge.							

Print Name of Pump Installer and License No. (if applicable)

0692

DAVE COOK

-

ъ.

Dave Corle Signature of Pump Installer

RECEIVED

FEB 0 6 2006

BY: OLWR