

State Well Report

Part 1 - Driller's Log

Mississippi Department of Environmental Quality
Office of Land and Water Resources
P.O. Box 2309
Jackson, MS 39225
(601)961- 5210
(601)961- 5228 (fax)

County: HARRISON
Permit #: _____
Driller: BEN CORBETT
Date drilling completed: 6/29/10

For Office Use Only:
Aquifer: M 941
Well #: _____
L. S. Elevation: _____
E-log #: _____

State Law requires that this report be prepared by the license holder responsible for the work and filed with the Department at the above address within 30 days of completion of drilling of the well or borehole.

Information on Well Owner <i>(Landowner if borehole is not for a water well)</i>	Well or Borehole Location
Owner Name: <u>REICHHOLD CHEMICAL</u>	Latitude: <u>30° 25' 45.27"</u> Longitude: <u>89° 1' 29.16"</u>
Mailing Address: <u>11015 REICHHOLD ROAD</u>	Method of Lat/Long (circle one): Conventional Survey, _____
<u>GULFPORT MS 39503</u> City State Zip Code	USGS quad, <u>(Hand-held GPS)</u> Survey-grade GPS
Telephone No. <u>(228) 896-6924</u>	<u>4E</u> <u>1/4</u> <u>4E</u> <u>1/4</u> Sec <u>18</u> Twn <u>15</u> Rng <u>10W</u> <u>NE NE</u> Direction <u>19</u> Nearest Town <u>GULFPORT, MS</u> <u>1</u> Miles <u>W</u> of _____

Well / Borehole Data

Date drilling started: 6/29/10 Date drilling completed: 6/29/10 Hole depth: 15' Hole diameter: 8 1/4"

Location of the source of any surface water used for drilling: KNOXVILLE, AL

Method of dosing and volume of Chlorine used in drilling and development: NONE

Logs run (circle all applicable): (No log run) Electric Gamma Ray Density Sonic Neutron Other: _____

Name of organization running log(s): _____

Purpose of borehole (check one): Water Well ___ Geotechnical/Geological Investigation Ground Source Heat Pump ___

Seismic Survey ___ Other (describe) _____

If drilling is not related to water well construction, skip the remainder of this block

Purpose of Well (check one): Home ___ Industrial ___ Public Supply ___ Irrigation ___ Fish Culture ___ Other: MONITORING

If a flowing well, method of flow regulation: Valve N/A Other (describe) _____

Static Water Level: 3 feet above or below (circle one) land surface Date measured: 7/1/10

Method of Measurement (circle one) (steel tape) electric tape air line other: _____

Well depth: 15' Well grouted to a depth of 4 feet Type of grout (circle one): Neat Cement (Bentonite) Mix

Casing length: 5' feet Casing diameter: 2" inches Type of casing: PVC

Screen length: 10' feet Screen diameter: 2" inches Type of screen: PVC

Screen slot size: 0.010" inches Setting depth: From 15' feet to 5' feet

Type of completion (circle all applicable): (Gravel packed) Underreamed Telescoped Open hole Natural Development

Other (describe): _____

Top of lap pipe or reduction in casing: N/A feet. *If telescoped or more than one screen, describe on next page*

Form: OLWR-SWR-1A (04/08)


RECEIVED
AUG 02 2010
BY: OLWR

M 961

The sketch below only required for water wells


Description of formations encountered must be provided for all wells and boreholes, unless specifically exempted by regulations

If well telescopes, show depths on sketch.

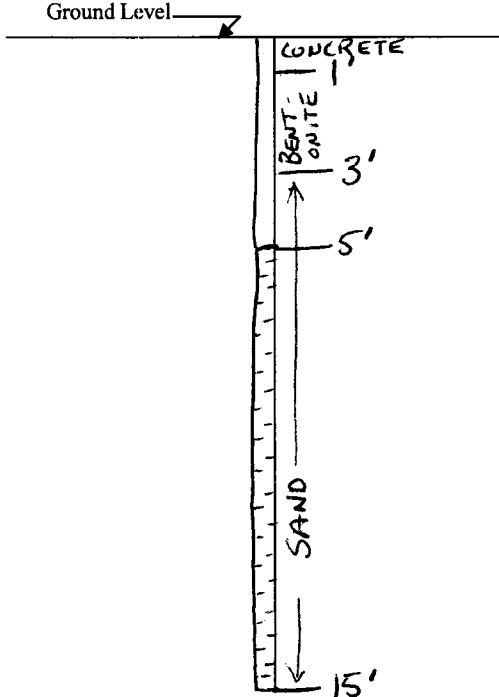

Description of Formations Encountered	From (depth) To (depth)	
	Ground Level	
EXISTING WELL WAS		
OVERDRILLED AND		
NEW WELL INSTALLED		
IN SAME BOREHOLE		

If more than one screen, show location of each on sketch

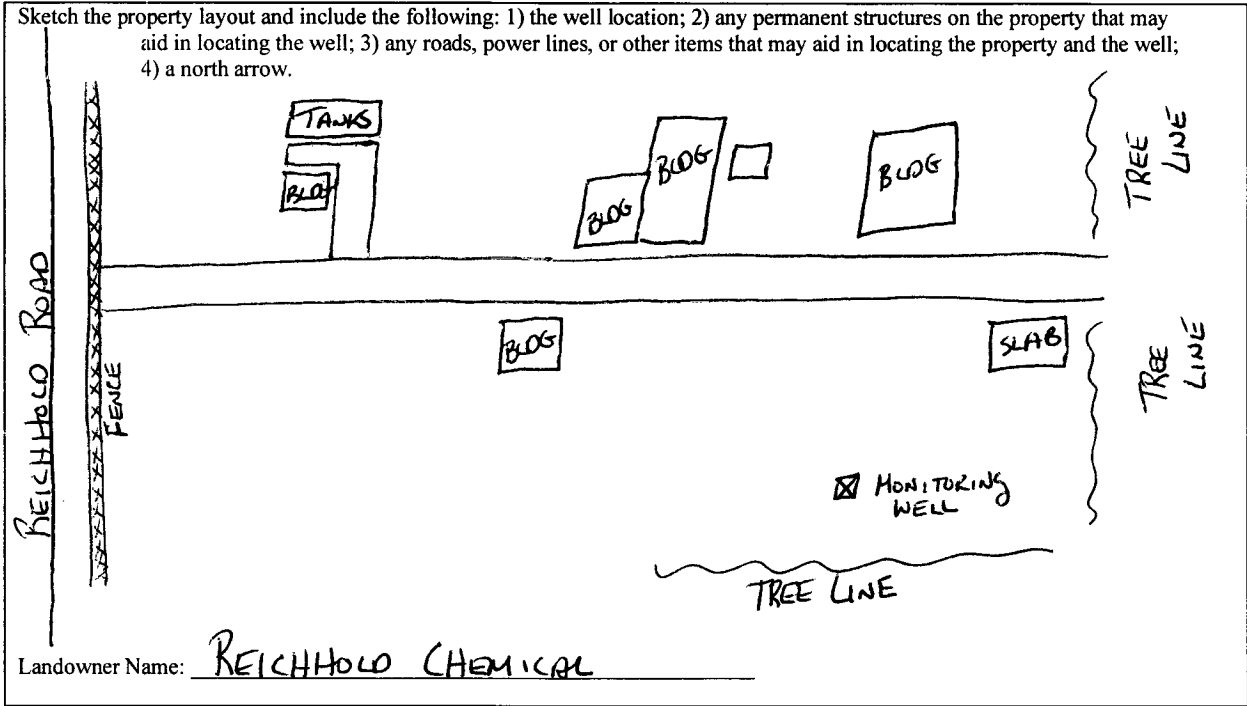

Form: OLWR-SWR-1A (04/08)

I certify that the well/borehole was drilled, constructed, and completed in accordance with all applicable requirements of the Mississippi Department of Environmental Quality and the Mississippi Department of Health regulations, if applicable, and state laws.

CURTIS LEE
 Print Name of Responsible Licensee and License No. Date

Curtis Lee
 Signature of Licensee

RECEIVED

AUG 02 2010

BY: OLWR