

HAR.  
M

2001

# WATER WELL DRILLERS LOG

Date: 1-4-61, 1961, Driller: C.T. Dintgen Well Co County Jackson  
(Name)

(1) Owner of Land: Mr. Charlie Flanagan  
(Name)

232 Reynoir Rd.  
N. Beloxi, Miss  
(Address)

(2) Location: 1/4, 1/4, Sec. T. R. 9  
\_\_\_\_\_ miles \_\_\_\_\_, of \_\_\_\_\_  
(distance) (direction) (Nearest Town)

(3) Topography: \_\_\_\_\_  
(Hilly) (Flat) (Level)

(4) Purpose of Well: \_\_\_\_\_  
(Domestic Irrigation  
Municipal, Industrial, Other)

Description & Color of Materials Sand, Clay, Red Clay, Shell, etc.	Thick- ness Feet	Depth Feet
Clay	0	18
Sand	17	35
Clay	180	145
Sand	195	15
Clay	252	53
Sand	296	46

### Information upon completion of well:

(1) Diameter 2 inches.

(2) Total Depth 296 feet.

(3) Water Level 3' feet below top of ground.

(4) Cased to 296, Size 2"


(5) Screen: Size 2", Length 10'

(6) Were any formations sealed against pollution?  
Yes, \_\_\_\_\_ no.

If YES depth of formation 10 FT.

Why Health Dept. Requirement

Drillers Remarks: \_\_\_\_\_

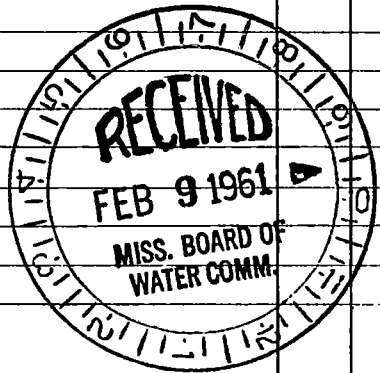

(Use Back Side)

Well No.

Retain this copy for your office files.

Handwritten notes at the top of the page, including a date "1971" and some illegible text.

Main body of handwritten notes, appearing as a list or series of entries, though the text is mostly illegible due to fading and bleed-through.

Handwritten text at the bottom of the page, possibly a signature or a concluding note.