

HAR. MISSISSIPPI BOARD OF WATER COMMISSIONERS

?

M 2507 M A 95705

WATER WELL DRILLERS LOG


4-28-61
Date: April 28, 19 61, Driller: C T Switzer Well Co County: Harrison

(Name)

(1) Owner of Land:	Description & Color of Materials Sand, Clay, Red Clay, Shell, etc.	Thick- ness Feet	Depth Feet
John Guave 118 Guave Rd (Name) (Address)	Clay sand	0	79
22 79 (Location: 1/4, 1/4, Sec. T R)	Clay sand	79	118
miles of (distance) (direction) (Nearest Town)	Clay sand	118	162
X (Topography: (Hilly) (Flat) (Level))	Clay sand	162	194
Domestic (Purpose of Well: Domestic Irrigation Municipal, Industrial, Other)	Clay sand	194	199
	Clay sand	199	212
	Clay sand	212	264
	Clay sand	264	284
	Clay sand	284	339
	Clay sand	339	374

Information upon completion of well:

- (1) Diameter 2" inches.
- (2) Total Depth 374' feet.
- (3) Water Level 6" feet below top of ground.
- (4) Cased to 374', Size 2"
- (5) Screen: Size 2", Length 10'
- (6) Were any formations sealed against pollution?
X yes, _____ no.

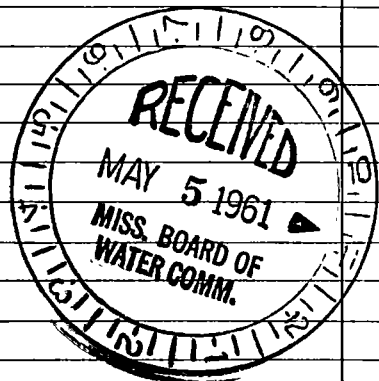

If YES depth of formation
Why Health Dept Requirement

Drillers Remarks:

(Use Back Side)

Well No.

