

HAR.

MISSISSIPPI BOARD OF WATER COMMISSIONERS

M 2008 M
5-23-61

WATER WELL DRILLERS LOG

?

Date: May 23, 1961, Driller: Switzer Well Co County Harrison
(Name)

(1) Owner of Land: <u>Bobby D O'Raille</u> (Name)	Description & Color of Materials Sand, Clay, Red Clay, Shell, etc.	Thick- ness Feet	Depth Feet
<u>Gay Road, Rt 2</u> (Address)	<u>Clay</u>	<u>0</u>	<u>41</u>
(2) Location: <u>1/4</u> , <u>1/4</u> , Sec. <u>7 R 9</u>	<u>Sandy peagravel</u>	<u>41</u>	<u>62</u>
_____ miles _____ of _____ (distance) (direction) (Nearest Town)	<u>sand</u>	<u>62</u>	<u>104</u>
(3) Topography: <u>X</u> (Hilly) (Flat) (Level)	<u>clay</u>	<u>104</u>	<u>167</u>
(4) Purpose of Well: <u>Domestic</u> (Domestic Irrigation Municipal, Industrial, Other)	<u>sand</u>	<u>167</u>	<u>188</u>
	<u>clay</u>	<u>188</u>	<u>212</u>
	<u>sand</u>	<u>212</u>	<u>242</u>


Information upon completion of well:

- (1) Diameter 2 inches.
- (2) Total Depth 242 feet.
- (3) Water Level 30' feet below top of ground.
- (4) Cased to 242', Size 2"
- (5) Screen: Size 2", Length 10'
- (6) Were any formations sealed against pollution?
X yes, _____ no.

If YES depth of formation _____

Why Health Dept Requirement

Drillers Remarks: _____

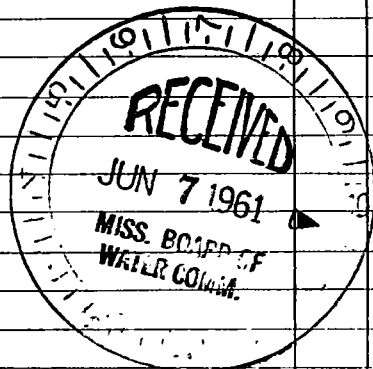

(Use Back Side)

Well No.

