

MISSISSIPPI BOARD OF WATER COMMISSIONERS

HAR.

M

A 93812

WATER WELL DRILLERS LOG

6-1-61 2009

Date: June 1, 1961, Driller: C. T. SWITZER WELL CO. County Harrison

(Name)

(1) Owner of Land: Dewey Fountain  
(Name)

Box 241 St Martin Rd  
(Address)

(2) Location: 1/4, 1/4, Sec. T 7 R 9  
(distance) (direction) (Nearest Town)

(3) Topography: X  
(Hilly) (Flat) (Level)

(4) Purpose of Well: Domestic  
(Domestic Irrigation Municipal, Industrial, Other)

Description & Color of Materials Sand, Clay, Red Clay, Shell, etc.	Thick- ness Feet	Depth Feet
clay	0	15
sand	15	31
clay	31	41
sand	41	77
clay	77	162
sand	162	195
clay	195	246
sand	246	251
clay	251	262
sand	262	304

Information upon completion of well:

(1) Diameter 2" inches.

(2) Total Depth 304 feet.

(3) Water Level 2' feet below top of ground.

(4) Cased to 304, Size 2"


(5) Screen: Size 2", Length 10

(6) Were any formations sealed against pollution?  
X yes,        no.

If YES depth of formation \_\_\_\_\_

Why: Health Dept Requirement

Drillers Remarks: \_\_\_\_\_

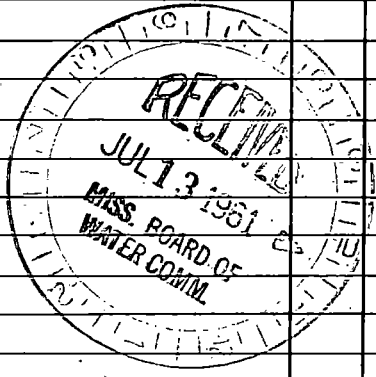

Well No.

(Use Back Side)

