

HAR.

M

M D 90702

WATER WELL DRILLERS LOG

?

Date: July, 1961, Driller: C. I. SWITZER WELL CO. County: Harrison
 (Name)


(1) Owner of Land: M T Shaw
 (Name)
136 Atkinson Rd
 (Address)
 (2) Location: 27 710
 1/4, 1/4, Sec. T R
 _____ miles _____ of _____
 (distance) (direction) (Nearest Town)
 (3) Topography: X
 (Hilly) (Flat) (Level)
 (4) Purpose of Well: Domestic
 (Domestic Irrigation
 Municipal, Industrial, Other)

Description & Color of Materials Sand, Clay, Red Clay, Shell, etc.	Thick- ness Feet	Depth Feet
sand	0	36
clay	36	67
sand	67	77
clay	77	104
clay w/ sand sh	104	125
clay	125	146
sand	146	161
clay	161	172
sand	172	198
clay	198	233
sand	233	241
clay	241	266
sand	266	295

Information upon completion of well:

(1) Diameter 2" inches.
 (2) Total Depth 295 feet.
 (3) Water Level 15' feet below top of ground.
 (4) Cased to 295, Size 2"
 (5) Screen: Size 2", Length 10'
 (6) Were any formations sealed against pollution?
X yes, _____ no.

If YES depth of formation _____
 Why Health Dept Requirement
 Drillers Remarks: _____

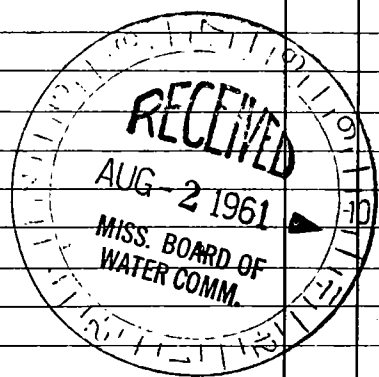

(Use Back Side)

Well No.

Handwritten notes at the top of the page, including the word "LIFE" and other illegible scribbles.

Main body of handwritten notes on a grid background. The text is mostly illegible due to heavy scribbling and bleed-through.

EPC

E/S

Handwritten signature or name at the bottom of the page, possibly "James H. ...".