

HAR.

M

7-11-61

M B 7509  
WATER WELL DRILLERS LOG

Date: July 11, 1961, Driller: C. T. SWITZER WELL CO. County: Hamilton  
(Name)


- (1) Owner of Land: Fred Schwan  
(Name)  
Forest Ave  
(Address)
- (2) Location: 1/4, 1/4, Sec. T 10 R  
South of Riv  
(direction) (Nearest Town)
- (3) Topography: X  
(Hilly) (Flat) (Level)
- (4) Purpose of Well: Domestic  
(Domestic Irrigation  
Municipal, Industrial, Other)

Description & Color of Materials Sand, Clay, Red Clay, Shell, etc.	Thick- ness Feet	Depth Feet
<u>sand</u>	<u>0</u>	<u>21</u>
<u>clay</u>	<u>21</u>	<u>26</u>
<u>sand</u>	<u>26</u>	<u>58</u>

Information upon completion of well:

- (1) Diameter 2" inches.
- (2) Total Depth 58' feet.
- (3) Water Level 15' feet below top of ground.
- (4) Cased to 58', Size 2"
- (5) Screen: Size 2", Length 10'
- (6) Were any formations sealed against pollution?  
X yes, no.

If YES depth of formation \_\_\_\_\_  
Why Health Dept Requirement  
Drillers Remarks: \_\_\_\_\_

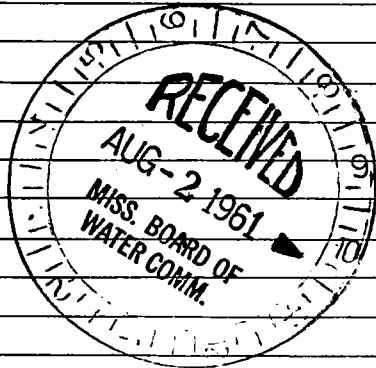

(Use Back Side)

Well No. \_\_\_\_\_

1911

1911

