

HAR.

M

WATER WELL DRILLERS LOG

2015  
8-2-61

Date: August 2, 1961, Driller: C. T. SWITZER WELL CO. County Harrison

(Name)

(1) Owner of Land: G & L Prater Court  
(Name)  
200 Baker St  
(Address)

Description & Color of Materials  
Sand, Clay, Red Clay, Shell, etc.

Thick-  
ness  
Feet

Depth  
Feet

sand

0 36

(2) Location: 1/4, 1/4, Sec. 7 10  
T R  
\_\_\_\_\_ miles \_\_\_\_\_ of \_\_\_\_\_  
(distance) (direction) (Nearest Town)

(3) Topography: X  
(Hilly) (Flat) (Level)

(4) Purpose of Well: Domestic  
(Domestic Irrigation  
Municipal, Industrial, Other)


Information upon completion of well:

- (1) Diameter 2' inches.
- (2) Total Depth 36 feet.
- (3) Water Level 4' feet below top of ground.
- (4) Cased to 36', Size 2"
- (5) Screen: Size 2", Length 6'
- (6) Were any formations sealed against pollution?  
X yes, \_\_\_\_\_ no.

If YES depth of formation \_\_\_\_\_

Why Health Dept Requirement

Drillers Remarks: \_\_\_\_\_

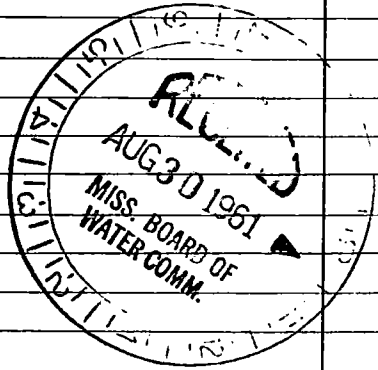

Well No.

(Use Back Side)

