

H.A.R.  
M

2016 M E 485712

WATER WELL DRILLERS LOG

7

8-3-61

Date: August 3, 1961, Driller: C. T. SWITZER WELL CO County Harrison  
(Name)

(1) Owner of Land: Dick Danner  
(Name)  
Shorecrest Rd  
(Address)

(2) Location: 1/4, 1/4, Sec. 7 10 T R  
Sub Div miles (distance) of (direction) (Nearest Town)

(3) Topography: X  
(Hilly) (Flat) (Level)

(4) Purpose of Well: Domestic  
(Domestic Irrigation  
Municipal, Industrial, Other)

Description & Color of Materials Sand, Clay, Red Clay, Shell, etc.	Thick- ness Feet	Depth Feet
<u>clay</u>	<u>0</u>	<u>20</u>
<u>sand</u>	<u>20</u>	<u>30</u>
<u>clay</u>	<u>30</u>	<u>54</u>
<u>sand</u>	<u>51</u>	<u>104</u>
<u>clay</u>	<u>104</u>	<u>125</u>
<u>sand</u>	<u>125</u>	<u>146</u>
<u>clay</u>	<u>146</u>	<u>198</u>
<u>sand</u>	<u>198</u>	<u>218</u>

Information upon completion of well:

(1) Diameter 2" inches.

(2) Total Depth 218 feet.


(3) Water Level 21' feet below top of ground.

(4) Cased to 218', Size 2"

(5) Screen: Size 2", Length 15'

(6) Were any formations sealed against pollution?  
X yes,        no.

If YES depth of formation \_\_\_\_\_  
Why Health Dept Requirement  
Drillers Remarks: \_\_\_\_\_

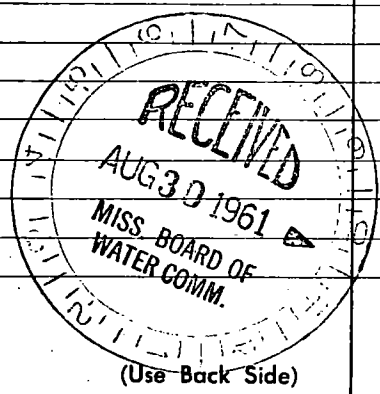

Well No. \_\_\_\_\_

