

M. 2020  
12-25-61

M D 91961  
D 29005

WATER WELL DRILLERS LOG

Date: 12-25, 1961, Driller: C. T. SWITZER WELL CO. County Harrison

(Name)


(1) Owner of Land: Richard Peacock  
(Name)  
Edgewater Drive & Pine Road  
(Address)  
28 7 10  
(2) Location: 1/4, 7/8, Sec. T R  
\_\_\_\_\_ miles \_\_\_\_\_ of \_\_\_\_\_  
(distance) (direction) (Nearest Town)  
(3) Topography: X  
(Hilly) (Flat) (Level)  
(4) Purpose of Well: Domestic  
(Domestic Irrigation  
Municipal, Industrial, Other)

| Description & Color of Materials<br>Sand, Clay, Red Clay, Shell, etc. | Thick-<br>ness<br>Feet | Depth<br>Feet |
|---|------------------------|---------------|
| Sand  | 00                     | 39            |
| Clay  | 39                     | 75            |
| Sand  | 75                     | 103           |
| Clay  | 103                    | 123           |
| Clay w/sand str.  | 123                    | 165           |
| Clay  | 165                    | 173           |
| Sand  | 173                    | 196           |
| Clay  | 196                    | 206           |
| Clay w/sand str.  | 206                    | 227           |
| Soft mud  | 227                    | 247           |
| Clay w/sand str.  | 247                    | 267           |
| Clay  | 267                    | 412           |
| Sand  | 412                    | 433           |

Information upon completion of well:

(1) Diameter 2" inches.  
(2) Total Depth 480 feet.  
(3) Water Level 14' feet below top of ground.  
(4) Cased to 430, Size 2"  
(5) Screen: Size 2", Length 15'  
(6) Were any formations sealed against pollution?  
X yes, \_\_\_\_\_ no.

If YES depth of formation \_\_\_\_\_  
Why Health Dept Requirement  
Drillers Remarks: \_\_\_\_\_

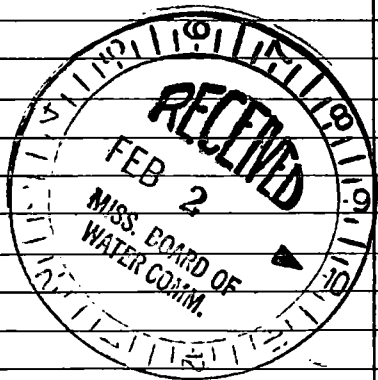

(Use Back Side)

Well No.

