

M 2021
12-28-61

WATER WELL DRILLERS LOG

Date: 12-28, 1961, Driller: C.T. Switzer Well Co., county Jackson
(Name)

(1) Owner of Land: W.W. Patterson
(Name)

N.W. Beloy on Cherokee Dr.
13th N.W. Highway 90 99

(2) Location: _____ 1/4, _____ 1/4, Sec. _____ T. _____ R. _____
_____ miles _____ of _____
(distance) (direction) (Nearest Town)

(3) Topography: _____
(Hilly) (Flat) (Level)

(4) Purpose of Well: Domestic
(Domestic Irrigation
Municipal, Industrial, Other)

Description & Color of Materials Sand, Clay, Red Clay, Shell, etc.	Thick- ness Feet	Depth Feet
Sand	0	9
Clay	6	15
Rock	19	34
Clay	26	60
Rock	2	62
Clay	21	83
Rock	1	84
Clay	41	125
Sand	43	168

Information upon completion of well:

(1) Diameter 2 inches.

(2) Total Depth 168 feet.

(3) Water Level -3 feet below top of ground.

(4) Cased to 168, Size 2 in


(5) Screen: Size 2 in, Length 10

(6) Were any formations sealed against pollution?
✓ yes, _____ no.

If YES depth of formation 10 ft.

Why Health Dept. Requirement

Drillers Remarks: _____

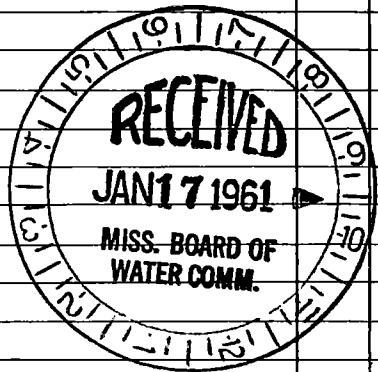

(Use Back Side)

Well No.

