

HAR.

MISSISSIPPI BOARD OF WATER COMMISSIONERS

M

2022  
1-30-62

WATER WELL DRILLERS LOG

(?)

Date: Jan 30, 1962, Driller: C. T. SWITZER WELL CO County: Harrison

(Name)

(1) Owner of Land:

Rock Hill

(Name)

Box 14 - Adley Rd, Henderson

(Address)

(2) Location:

1/4, 1/4, Sec. T 10 R

\_\_\_\_\_ miles  
(distance)

\_\_\_\_\_ of  
(direction)

\_\_\_\_\_ of  
(Nearest Town)

(3) Topography:

(Hilly)

(Flat)

(Level)

(4) Purpose of Well:

Domestic  
(Domestic Irrigation  
Municipal, Industrial, Other)

Information upon completion of well:

(1) Diameter:

2 inches.

(2) Total Depth:

245 feet.

(3) Water Level:

20' feet below top of ground.

(4) Cased to:

245', Size 2"

(5) Screen: Size:

2", Length 10'

(6) Were any formations sealed against pollution?

X

yes, \_\_\_\_\_ no.

If YES depth of formation \_\_\_\_\_

Why: Health Dept Requirement


Drillers Remarks: \_\_\_\_\_

Description & Color of Materials  
Sand, Clay, Red Clay, Shell, etc.

Thick-  
ness  
Feet

Depth  
Feet

Sand	00	36
Clay	36	50
Sand	50	60
Sand, good	60	102
Sand & gravel	102	142
Clay	142	187
Sand	187	202
Sand, good	202	245

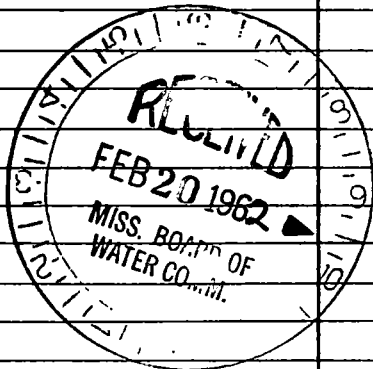

(Use Back Side)

Well No.

