


HAR.

M 2023
2-12-62

WATER WELL DRILLERS LOG

Date: Feb. 12, 1962, Driller: Joe Miller County Jackson
(Name)

(1) Owner of Land:	Description & Color of Materials Sand, Clay, Red Clay, Shell, etc.	Thick- ness Feet	Depth Feet
Belly Enix <small>(Name)</small> Beloxi Miss <small>(Address)</small>	Surface	8	8
Location: 1/4, 1/4, Sec. 34 T. 7 R. 10	Wh Sand	71	29
2 miles North of Beloxi <small>(Distance) (direction) (Nearest Town)</small>	Blue clay	51	80
Topography: Flat <small>(Hilly) (Flat) (Level)</small>	Cl & Sand, Break.	62	142
Purpose of Well: Domestic <small>(Domestic Irrigation Municipal, Industrial, Other)</small>	Pale Cl	185	327
Information upon completion of well:	Sand. Fine	9	336
(1) Diameter 2 inches.	Hard Blue cl	39	375
(2) Total Depth 842 feet.	Hard Blue cl	19	394
(3) Water Level flowing feet below top of ground.	Fine Sand	14	400
(4) Cased to 807, Size 2"	Clay & Shells.	14	400
(5) Screen: Size 2', Length 30'	Hd Clay Blue	310	710
(6) Were any formations sealed against pollution?	Sand. Fine	69	779
yes, no.	Mud in Cl & Sand	21	718
If YES depth of formation	Sand Fine	10	788
Why	Sand - Fine	10	798
Drillers Remarks: Flowing	Sand - Good	30	828
2000 G P.H. at ground level	Cl & Sand NG		841
10' Head	Used 24' Tubing		

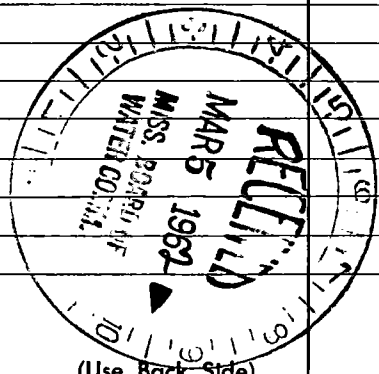

Well No. :

St Mark's School

old Her 90

Jackson
Cramer
fire

old
Hill

Ericks

69

Barb Bay

