

HAR.

MISSISSIPPI BOARD OF WATER COMMISSIONERS

M 2024

2-28-62


WATER WELL DRILLERS LOG

(?)

Date: 2-28, 1962, Driller: T. SWITZER WELL CO. County: Harrison

(Name)

| | Description & Color of Materials Sand, Clay, Red Clay, Shell, etc. | Thick- ness Feet | Depth Feet |
|---|---|------------------------|---------------|
| (1) Owner of Land: <u>Beyon Motel</u> (Name) <u>W. Beach Biloxi, Miss.</u> (Address) | Sand | 00 | 54 |
| (2) Location: <u>1/4</u> , <u>1/4</u> , Sec. <u>T 7 R 10</u> <u> </u> miles <u> </u> of <u> </u> (distance) (direction) (Nearest Town) | Clay | 54 | 126 |
| (3) Topography: <input checked="" type="checkbox"/> (Hilly) <input type="checkbox"/> (Flat) <input type="checkbox"/> (Level) | Clay sand streaks | 126 | 166 |
| (4) Purpose of Well: <u>Domestic</u> (Domestic Irrigation Municipal, Industrial, Other) | Sand | 166 | 172 |
| Information upon completion of well: | Clay | 172 | 180 |
| (1) Diameter <u>3 x 2</u> inches. | Sand | 180 | 186 |
| (2) Total Depth <u>688</u> feet. | Clay | 186 | 206 |
| (3) Water Level <u>4'</u> feet below top of ground. | Sand stks. | 206 | 226 |
| (4) Cased to <u>688'</u> , Size <u>"3 x 2"</u> | Soft clay | 226 | 247 |
| (5) Screen: Size <u>3" x 2"</u> , Length <u>20'</u> | Clay | 247 | 268 |
| (6) Were any formations sealed against pollution? <input checked="" type="checkbox"/> yes, <input type="checkbox"/> no. | Soft clay | 268 | 288 |
| If YES depth of formation <u> </u> | Clay | 288 | 308 |
| Why <u>Health Dept. Requirement</u> | Sand | 308 | 318 |
| Drillers Remarks: <u> </u> | Clay | 318 | 449 |
| <u> </u> | Clay & shell | 449 | 490 |
| <u> </u> | Sand | 490 | 502 |
| <u> </u> | Clay | 502 | 510 |
| <u> </u> | Sand stks | 510 | 530 |
| | Clay | 530 | 551 |
| | Sand | 551 | 561 |
| | Clay | 561 | 571 |
| | Sand, flint | 571 | 592 |
| | Clay sand streaks | 592 | 612 |
| | Sand, fine | 612 | 632 |
| | Sand, fine | 632 | 688 |

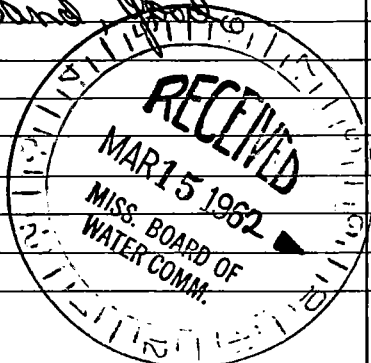

(Use Back Side)

Well No.

[The text on this page is extremely faint and mostly illegible. It appears to be a list of names and possibly addresses or locations, arranged in several columns. Some words like 'No.' and 'St.' are faintly visible at the top.]