

W.R.
M 2025
2-28-62

MISSISSIPPI BOARD OF WATER COMMISSIONERS

D 17574

WATER WELL DRILLERS LOG

(2)

Date: 2-28, 1962, Driller: G. I. SWITZER WELL CO. County Woodson

(Name)

(1) Owner of Land: William D. Early
(Name)
Rapp's Ferry Rd Biloxi
(Address)
35 7 10

(2) Location: 1/4, 1/4, Sec. T R,
_____ miles _____ of _____
(distance) (direction) (Nearest Town)

(3) Topography: (Hilly) (Flat) (Level)

(4) Purpose of Well: Domestic
(Domestic Irrigation
Municipal, Industrial, Other)

Description & Color of Materials Sand, Clay, Red Clay, Shell, etc.	Thick- ness Feet	Depth Feet
<u>Sand</u>	<u>00</u>	<u>10</u>
<u>Clay</u>	<u>10</u>	<u>20</u>
<u>Sand</u>	<u>70</u>	<u>80</u>
<u>Sand, good</u>	<u>80</u>	<u>100</u>
<u>Clay</u>	<u>100</u>	<u>120</u>
<u>Sand, fine</u>	<u>120</u>	<u>140</u>
<u>Clay</u>	<u>140</u>	<u>250</u>
<u>Sand, fine</u>	<u>250</u>	<u>281</u>
<u>Clay</u>	<u>281</u>	<u>302</u>
<u>Sand, good</u>	<u>302</u>	<u>342</u>

Information upon completion of well:

(1) Diameter 2 inches.

(2) Total Depth 342 feet.


(3) Water Level 11 feet below top of ground.

(4) Cased to 342', Size 2"

(5) Screen: Size 2", Length 10'

(6) Were any formations sealed against pollution?
 yes, no.

If YES depth of formation _____
Why Health Dept Requirement
Drillers Remarks: _____

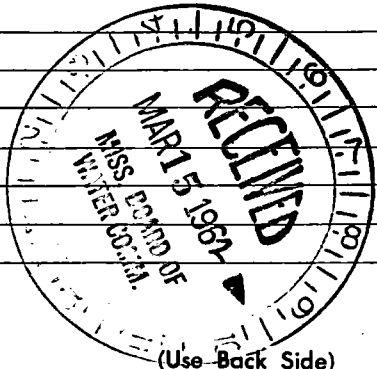

Well No.

01 02
03 04
05 06
07 08
09 10
11 12
13 14
15 16
17 18
19 20
21 22
23 24
25 26
27 28
29 30
31 32

Handwritten notes and signatures, including the name "Adriano" and "P.S." at the top right. The text is mostly illegible due to fading and bleed-through.

