

HAR. MISSISSIPPI BOARD OF WATER COMMISSIONERS

M 2026 M
5-23-62

WATER WELL DRILLERS LOG

(?)
0

Date: 5-23, 1962, Driller: C. T. SWITZER WELL CO. County: Harrison

(Name)

(1) Owner of Land: H. W. M. Morrow
(Name)
Corner of Ross Rd & Delcup Rd
(Address) 710

(2) Location: 1/4, 1/4, Sec. 1 T. R
10
miles of
(distance) (direction) (Nearest Town)

(3) Topography: (Hilly) (Flat) (Level)

(4) Purpose of Well: service station
(Domestic Irrigation, Municipal, Industrial, Other)

Description & Color of Materials Sand, Clay, Red Clay, Shell, etc.	Thick- ness Feet	Depth Feet
Sand	00	37
Clay	37	70
Sand	70	99
Clay	99	126
Sand	126	131
Sand, sibs	131	167
Sand, extra fine	167	208
Clay	208	331
Clay & Sand sibs	331	352
Soft Clay	352	373
Clay	373	558
Clay & Sand sibs	558	578
Sand	578	684

Information upon completion of well:

(1) Diameter 3x2 inches.

(2) Total Depth 684' feet.


(3) Water Level 22' feet below top of ground.

(4) Cased to 684', Size 3x2"

(5) Screen: Size 3x2", Length 20'

(6) Were any formations sealed against pollution?
 yes, no.

If YES depth of formation _____
Why Health Dept. Requirement
Drillers Remarks: _____

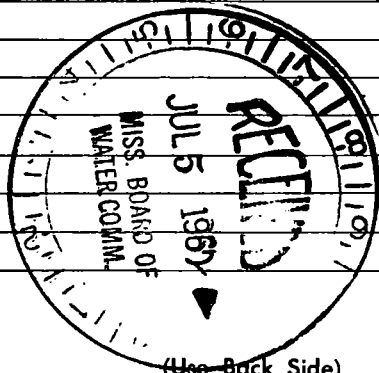

Well No.

Handwritten text at the top of the page, possibly a header or title.

Main body of handwritten text, appearing to be a list or series of entries.

Continuation of handwritten text, possibly a second list or section.

Handwritten text at the bottom of the page, possibly a signature or footer.