

HAR.

MISSISSIPPI BOARD OF WATER COMMISSIONERS

(7)
(0)

M 2027
5-29-62

WATER WELL DRILLERS LOG

Date: 5-29, 1962, Driller: C. T. SWITZER WELL CO. County Harrison

(Name)

(1) Owner of Land: Doc W. Knox
(Name)

Bellevue Bay Road
(Address)

(2) Location: 1/4, 1/4, Sec. T 7 R 10

 miles of
(distance) (direction) (Nearest Town)

(3) Topography:
(Hilly) (Flat) (Level)

(4) Purpose of Well: Domestic
(Domestic Irrigation
Municipal, Industrial, Other)

Description & Color of Materials Sand, Clay, Red Clay, Shell, etc.	Thick- ness Feet	Depth Feet
Clay	00	19
Sand str	19	25
Coarse Sand	25	45
Sand & Gravel	45	65
Sand	65	75
Clay	75	95
Sand	85	95
Clay	95	105
Clay, sand str	105	125
Clay	125	166
Clay, sand str	166	186
Clay	186	320
Sand str	320	390
Clay	390	405
Sand	405	410
Clay	410	421
Sand str	421	491
Clay	491	506
Sand	506	511
Clay	511	554
Sand	554	572
Clay	572	668
Sand	668	673
Clay	673	708
Sand	708	786

Information upon completion of well:

(1) Diameter 2 inches.

(2) Total Depth 786 feet.

(3) Water Level 2 1/2' feet below top of ground.

(4) Cased to 786', Size 2"


(5) Screen: Size 2", Length 20'

(6) Were any formations sealed against pollution?
 yes, no.

If YES depth of formation

Why Health Dept Requirement

Drillers Remarks:

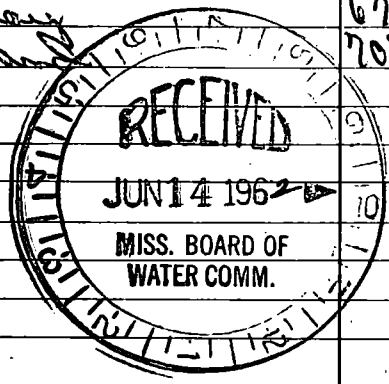

(Use Back Side)

Well No.

Retain this copy for your office files.

Handwritten notes at the top left.

Handwritten notes at the top right.

Vertical list of handwritten notes on the left side of the page.

Vertical list of handwritten notes in the middle section of the page.

Handwritten notes at the top of the right-hand column.

Main body of handwritten notes in the right-hand column.

Handwritten notes at the bottom of the right-hand column.