

M 2028
6-7-62

M B 71710 - 11

WATER WELL DRILLERS LOG

D 15413

C. T. SWITZER WELL CO.

Date: 6-7, 1962, Driller: _____ County: Harrison

(Name)

(1) Owner of Land: Vernon W. Smith
(Name)

Lawrence Rd
(Address)

(2) Location: 1/4 Sec. 710
(distance) (direction) (Nearest Town)

(3) Topography: (Hilly) (Flat) (Level)

(4) Purpose of Well: Domestic
(Domestic Irrigation Municipal, Industrial, Other)


Description & Color of Materials Sand, Clay, Red Clay, Shell, etc.	Thick- ness Feet	Depth Feet
Clay	60	60
Sand, red	60	120
Clay	80	200
Clay Sand Str	100	300
Clay	120	420
Sand, fine	160	580
Clay	180	760
Sand	216	976
Sand good	260	1236

Information upon completion of well:

- (1) Diameter 2 inches.
- (2) Total Depth 296' feet.
- (3) Water Level 13' feet below top of ground.
- (4) Cased to 296', Size 2"
- (5) Screen: Size 2", Length 10'
- (6) Were any formations sealed against pollution?
 yes, no.

If YES depth of formation _____
Why Health Dept Requirement

Drillers Remarks: _____

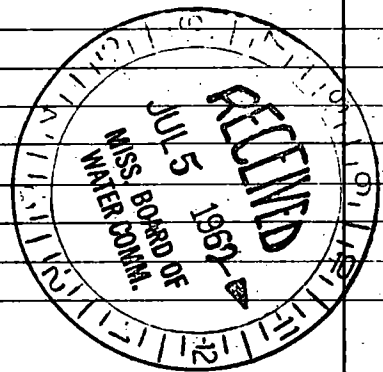

Well No.

100

100

