

MISSISSIPPI BOARD OF WATER COMMISSIONERS

HAR.

M

2029

WATER WELL DRILLERS LOG

6-28-62

Date: June 27, 1962, Driller: Meigs Drilling Co., County Harrison  
 (Name)

(1) Owner of Land: Mr. Kate  
 (Name)  
245 Duane Rd. N. B. Cox, Miss  
 (Address)  
 99  
 (2) Location: 1/4, 1/4, Sec. T. R.  
In miles North B. Cox  
 (distance) (direction) (Nearest Town)  
 (3) Topography: Flat  
 (Hilly) (Flat) (Level)  
 (4) Purpose of Well: Domestic for 6 Horses  
 (Domestic Irrigation  
 Municipal, Industrial, Other)

Description & Color of Materials Sand, Clay, Red Clay, Shell, etc.	Thick- ness Feet	Depth Feet
Clay	14	14
White Sand	21	35
" Clay	10	45
" Sand	10	55
Blue Clay	75	130
Sand + Clay Breaks	28	158
Blue Clay	142	300
Sand + Clay Breaks	18	318
Grey Sand	42	360


Information upon completion of well:

(1) Diameter 2 inches.  
 (2) Total Depth 357 feet.  
 (3) Water Level 0 feet below top of ground.  
 (4) Cased to 337, Size 2"  
 (5) Screen: Size 2" 8/16, Length 20 FT.  
 (6) Were any formations sealed against pollution?  
 \_\_\_\_\_ yes, \_\_\_\_\_ no.

If YES depth of formation \_\_\_\_\_

Why \_\_\_\_\_

Drillers Remarks: \_\_\_\_\_

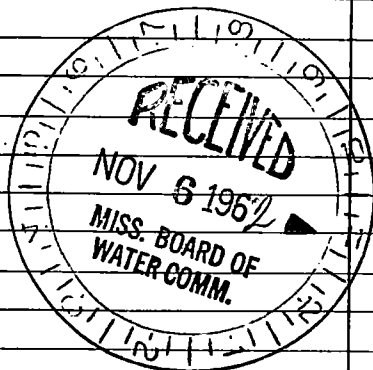

Well No.

(Use Back Side)

Handwritten text at the top of the page, possibly a header or title.

Handwritten text in the upper middle section.

Handwritten text in the middle section.

Handwritten text in the lower middle section, including numbers like 532, 537, and 547.

532

0

537

547

547