

HAR.

M 2031

7-3-62

WATER WELL DRILLERS LOG

(?) Harrison

Date: July 3, 1962, Driller: M & B Drilling Co. County: Harrison

(Name)

(1) Owner of Land: Ray Williams
 (Name)
Beach Bayou Rd. N. Biloxi Miss
 (Address)
 & Mike N. of Back Bay
 (2) Location: $\frac{1}{4}$, $\frac{1}{4}$, Sec 210 T 7 N
1/4 miles N. Biloxi of _____
 (distance) (direction) (Nearest Town)

(3) Topography: Flat
 (Hilly) (Flat) (Level)

(4) Purpose of Well: Domestic
 (Domestic Irrigation
 Municipal, Industrial, Other)

Description & Color of Materials Sand, Clay, Red Clay, Shell, etc.	Thick- ness Feet	Depth Feet
Clay	3	3
Sand	5	8
Clay	17	25
White Sand	7	32
Blue Clay	160	192
White Sand	18	210
Blue Clay	30	240
Grey Sand	10	250
Blue Clay	17	267
Grey Sand	10	277
Blue Clay	45	322
Grey Medium Sand	38	360
Blue Clay	360 -	

Information upon completion of well:

(1) Diameter 2 inches.

(2) Total Depth 357 feet.

(3) Water Level 0 feet below top of ground.

(4) Cased to 347, Size 2"


(5) Screen: Size 2" 8/16 Length 10 FT.

(6) Were any formations sealed against pollution?
 _____ yes, _____ no.

If YES depth of formation _____

Why _____

Drillers Remarks: _____

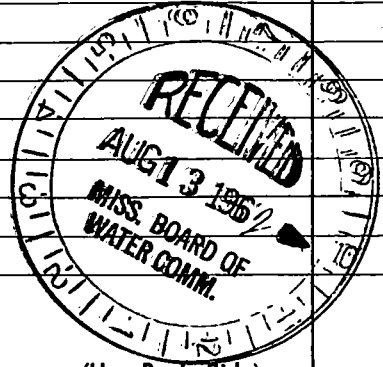

(Use Back Side)

Well No.

