

MISSISSIPPI BOARD OF WATER COMMISSIONERS

HAR.

M 2033

WATER WELL DRILLERS LOG

(?)

Date: July 6, 1962 Driller: M & B Drilling Co. County Harrison
 (Name)

(1) Owner of Land: Albert Pickard
 (Name)
Race Track Rd + Beach Boyer Ave.
N. Biloxi, Miss.
 (Address)

(2) Location: 1/4, 1/4, Sec. 19 T. R.
1 miles North, of Biloxi
 (distance) (direction) (Nearest Town)

(3) Topography: Flat
 (Hilly) (Flat) (Level)

(4) Purpose of Well: Domestic
 (Domestic Irrigation
 Municipal, Industrial, Other)

Description & Color of Materials Sand, Clay, Red Clay, Shell, etc.	Thick- ness Feet	Depth Feet
Clay	15	15
Sand	7	22
Clay	8	30
White Sand	8	38
Blue Clay	152	190
White Sand	14	204
Blue Clay	46	250
Grey Sand fine	20	270
Blue Clay	60	330
Grey Sand	32	362
Blue Clay		


Information upon completion of well:

(1) Diameter 2 inches.
 (2) Total Depth 362 feet.
 (3) Water Level 1 feet below top of ground.
 (4) Cased to 342, Size 2"
 (5) Screen: Size 2" 8 slot, Length 10 FT.
 (6) Were any formations sealed against pollution?
 _____ yes, _____ no.

If YES depth of formation _____

Why _____

Drillers Remarks: _____

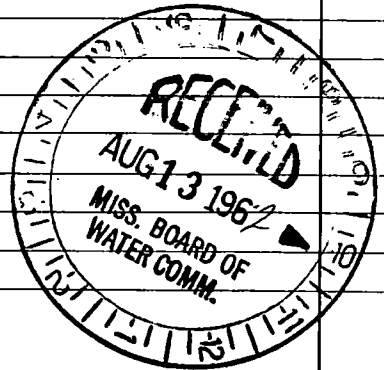

(Use Back Side)

Well No.

Handwritten notes at the top of the page, including the word "Bacteria" and some illegible scribbles.

Handwritten notes in the middle section, including the word "Bacteria" and some illegible scribbles.

Handwritten notes in the lower section, including the word "Bacteria" and some illegible scribbles.