

HAR.

MISSISSIPPI BOARD OF WATER COMMISSIONERS

M 20³⁴

7-11-62


WATER WELL DRILLERS LOG

(?)

Date: 7-11, 19___, Driller: G. T. SWITZER WELL CO. County: Harrison

(Name)

(1) Owner of Land: <u>Hunt Water Co.</u> (Name)	Description & Color of Materials Sand, Clay, Red Clay, Shell, etc.	Thick- ness Feet	Depth Feet
<u>Branch Blvd. Bienville, Miss.</u> (Address)	Clay	00	19
(2) Location: ___ 1/4, ___ 1/4, Sec. <u>30-7-10</u> T R	Sand	19	34
___ miles ___ of ___ (distance) (direction) (Nearest Town)	Clay	34	44
(3) Topography: <input checked="" type="checkbox"/> (Hilly) <input type="checkbox"/> (Flat) <input type="checkbox"/> (Level)	Sand & silt	44	84
(4) Purpose of Well: <u>Domestic</u> (Domestic Irrigation Municipal, Industrial, Other)	Clay	84	166
Information upon completion of well:	Sand	166	176
(1) Diameter <u>4</u> inches.	Clay	176	186
(2) Total Depth <u>874</u> feet.	Sand	186	198
(3) Water Level <u>11'</u> feet below top of ground.	Clay	198	246
(4) Cased to <u>874'</u> , Size <u>4"</u>	Sand, fine	246	261
(5) Screen: Size <u>4"</u> , Length <u>40'</u>	Clay	266	322
(6) Were any formations sealed against pollution? <input checked="" type="checkbox"/> yes, <input type="checkbox"/> no.	Sand	322	339
If YES depth of formation _____	Clay	339	347
Why <u>Health Dept. Requirement</u>	Clay & sand silt	347	367
Drillers Remarks: _____	Clay	367	427
	Sand silt	427	447
	Clay	447	488
	Sand	488	508
	Sand silt	508	528
	Clay	528	568
	Clay, sand silt	568	588
	Sand	588	598
	Sand silt	598	614
	Sand	614	650
	Clay	650	660
	Clay	660	690
	Sand	690	721
	Clay	721	731
	Sand	731	872

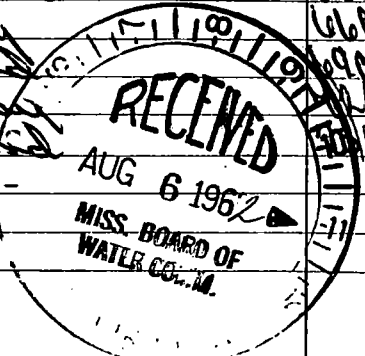

(Use Back Side)

Well No.

