

HAR. MISSISSIPPI BOARD OF WATER COMMISSIONERS

M

2035

A 94902

M

7-20-62

WATER WELL DRILLERS LOG

Date: July 20, 1962, Driller: M & B Drilling Co. County Harrison

(Name)

(1) Owner of Land: N. K. Nelson
(Name)

243 Byrd Ave. DeBonneville, Miss
(Address)

(2) Location: $\frac{1}{4}$, 21 $\frac{1}{4}$, Sec. 7 T 9 R

 miles , of
(distance) (direction) (Nearest Town)

(3) Topography: Flat
(Hilly) (Flat) (Level)

(4) Purpose of Well: Domestic
(Domestic Irrigation
Municipal, Industrial, Other)

Description & Color of Materials Sand, Clay, Red Clay, Shell, etc.	Thick- ness Feet	Depth Feet
Clay	10	10
White Clay	10	20
White Sand	6	26
Blue Clay	160	186
Fine Sand	26	212
Blue Clay	22	334
Grey Sand	27	361

Information upon completion of well:

(1) Diameter 2 inches.

(2) Total Depth 360 feet.

(3) Water Level 3 feet below top of ground.

(4) Cased to 350, Size 2"


(5) Screen: Size 2" x 2 1/8", Length 10 FT.

(6) Were any formations sealed against pollution?
 yes, no.

If YES depth of formation

Why

Drillers Remarks:

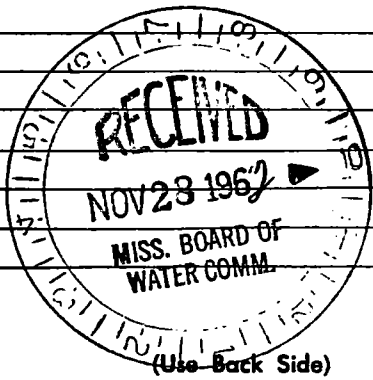

Well No.

