

M 36  
9-5262

WATER WELL DRILLERS LOG

Date: 9-5, 1962, Driller: C. T. SWITZER WELL CO. County: Harrison

(Name)

(1) Owner of Land: Henry Big  
(Name)

old Hwy. 90, Biloxi  
(Address)

(2) Location: 1/4, 1/4, Sec. T 10 R  
\_\_\_\_\_ miles \_\_\_\_\_ of \_\_\_\_\_  
(distance) (direction) (Nearest Town)

(3) Topography:  (Level)  
(Hilly) (Flat)

(4) Purpose of Well: Domestic  
(Domestic Irrigation  
Municipal, Industrial, Other)

Description & Color of Materials Sand, Clay, Red Clay, Shell, etc.	Thick- ness Feet	Depth Feet
Clay	00	20
Sand, good	20	40
Sand + clay shls	60	80
Clay	40	60
Sand, good	90	90
Clay	90	105
Sand	105	120
Sand, good	120	150

Information upon completion of well:

(1) Diameter 2 inches.

(2) Total Depth 150 feet.

(3) Water Level 2' feet below top of ground.


(4) Cased to 150', Size 2"

(5) Screen: Size 2", Length 10'

(6) Were any formations sealed against pollution?  
 yes, \_\_\_\_\_ no.

If YES depth of formation \_\_\_\_\_  
Why Health Dept. Requirement

Drillers Remarks: \_\_\_\_\_  
\_\_\_\_\_  
\_\_\_\_\_

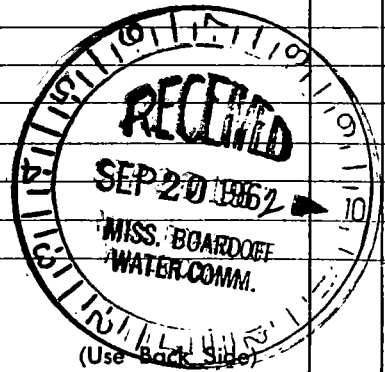

Well No. \_\_\_\_\_

~~HUNT~~

~~863 5954~~