

HAR.

M 2039

10-3-62

MISSISSIPPI BOARD OF WATER COMMISSIONERS

D 92064

WATER WELL DRILLERS LOG

C. T. SWITZER WELL CO.

Date: 10-3, 1962, Driller: County Harrison

(Name)


	Description & Color of Materials Sand, Clay, Red Clay, Shell, etc.	Thick- ness Feet	Depth Feet
(1) Owner of Land: <u>R.O. Holt</u> (Name)	Sand	00	30
<u>W. Beach, Biloxi, Miss.</u> (Address)	Clay	30	55
(2) Location: _____ 1/4, _____ 1/4, Sec. _____ T _____ R _____	Sand	55	60
_____ miles _____ of _____ (distance) (direction) (Nearest Town)	Sand, good	200	70
(3) Topography: _____ (Hilly) (Flat) (Level)	Clay	40	140
(4) Purpose of Well: <u>Domestic</u> (Domestic Irrigation Municipal, Industrial, Other)	Sand, good	140	170
	Clay	140	170
	Sand	195	200
	Sand, good	200	230

Information upon completion of well:

- (1) Diameter 2 inches.
- (2) Total Depth 230' feet.
- (3) Water Level 10' feet below top of ground.
- (4) Cased to 230', Size 2"
- (5) Screen: Size 2", Length 10'
- (6) Were any formations sealed against pollution?
 yes, no.

If YES depth of formation _____
Why Health department requirement

Drillers Remarks: _____

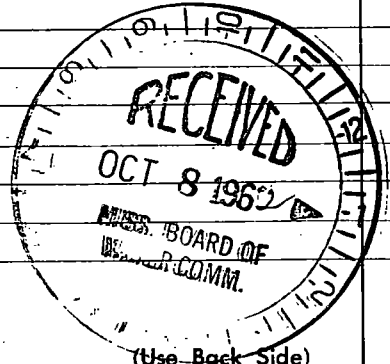

Well No. _____

