

HAR. MISSISSIPPI BOARD OF WATER COMMISSIONERS

M 2040 AF
10-23-62

WATER WELL DRILLERS LOG

Date: 10-23, 1962, Driller: C. T. SWITZER WELL CO. County: Harrison

(Name)

(1) Owner of Land: A. W. Carson
(Name)
Box 1, Yuffert, Harrison Rd.
(Address)

(2) Location: 7 R
_____ 1/4, _____ 1/4, Sec. _____ T. R. _____
_____ miles _____ of _____
(distance) (direction) (Nearest Town)

(3) Topography: (Hilly) (Flat) (Level)

(4) Purpose of Well: Domestic
(Domestic Irrigation
Municipal, Industrial, Other)

Description & Color of Materials Sand, Clay, Red Clay, Shell, etc.	Thick- ness Feet	Depth Feet
Clay	00	31
band	31	42
band, sand	42	43
Clay	43	105
band	105	115
Clay	115	202
band	202	210
band, sand	210	240

Information upon completion of well:

(1) Diameter 2 inches.

(2) Total Depth 240' feet.

(3) Water Level 22' feet below top of ground.

(4) Cased to 240', Size 2"


(5) Screen: Size 2", Length 14'

(6) Were any formations sealed against pollution?
 yes, _____ no.

If YES depth of formation _____

Why health department requirement

Drillers Remarks: _____

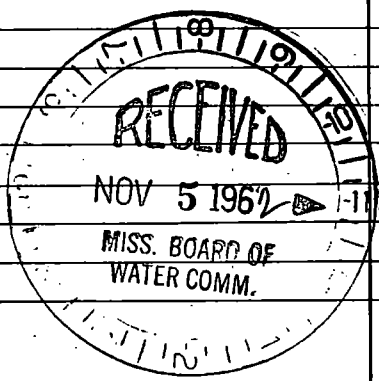

(Use Back Side)

Well No.

