

HAR. MISSISSIPPI BOARD OF WATER COMMISSIONERS

M. 2041  
11-1-62

WATER WELL DRILLERS LOG

Date: 11-1, 1962, Driller: C. T. SWITZER WELL CO. County Harrison  
(Name)

(1) Owner of Land: Edward Korbrough  
Popp's Ferry Rd. (Name)  
Harrison, Miss. Below  
(Address)

(2) Location: 7 10 T R  
7 10 miles of  
(distance) (direction) (Nearest Town)

(3) Topography: Flat  
(Hilly) (Flat) (Level)

(4) Purpose of Well: Domestic  
(Domestic Irrigation  
Municipal, Industrial, Other)

Description & Color of Materials Sand, Clay, Red Clay, Shell, etc.	Thick- ness Feet	Depth Feet
Clay	00	10
Sand	10	25
Clay	25	30
sand, good	30	140
Clay	110	160
sand, good	160	195
Clay	195	270
sand, good	270	370

Information upon completion of well:

(1) Diameter 2 inches.

(2) Total Depth 340 feet.

(3) Water Level 34' feet below top of ground.


(4) Cased to 340', Size 2"

(5) Screen: Size 2", Length 10'

(6) Were any formations sealed against pollution?  
✓ yes, no.

If YES depth of formation  
Why health dept. requirement

Drillers Remarks:

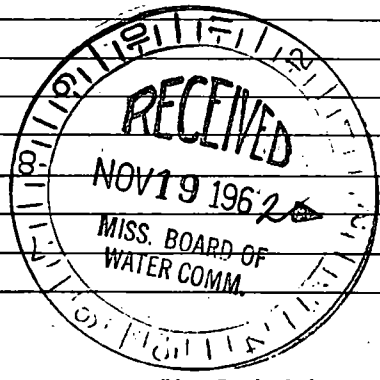

(Use Back Side)

Well No.

1870

1870

917 80  
918 80  
919 80  
920 80  
921 80  
922 80  
923 80  
924 80

Yours truly  
J. W. [Name]  
[Address]  
[City, State]

Very truly yours,  
J. W. [Name]